
PUBLIC LAND U.S. SURVEY MONUMENT RECORD

For Public Land Survey Corners in:

WI ADMINISTRATIVE CODE A-E 7.08 REQUIREMENT

T. 3N., R. 14 E

CORNER CODE INDEX

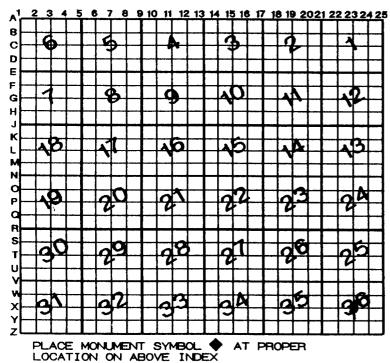

John	NSTOWN	TWP
•	COUNTY	

IF AVAILABLE ROCK COUNTY COORDINATES PERFERRED

Elev
Vert. Datum
ELLIPS. H
·
TRAVERSE (X)
OLLOWING CONTROL:

♦ CORNER MONUMEN	T
------------------	---

WITNESS MONUMENT

BEARINGS ARE BASED ON:

(a)

		,	. /	/
FIELD BOOK	PAGE #	SHEET	OF	
SHOW A PLAN VIEW	DRAWING DEPICTING THE CORNER MONUMENT	AND SURRO	UNDING	
PHYSICAL FEATURES,	INCLUDING THE EXCAVATION AREA AND DEPTH	H.		

PLANNING & ZONING COMMITTEE ADOPTED THE ABOVE FORM ON 12/2/1982

CORNER CODE

J08619

- (B)Describe any record evidence, monument evidence, occupational evidence, testimonial evidence or any other material evidence you considered, and whether the monument was found or placed.

 PAVEMENT WILL BE GROUND OUT & ROAD PAVED WITH ASPHALT. SEARCHED AND FOUND NOTHING AT SURFACE OF PAVEMENT.
- C) Was the corner restored through acceptance of (1) an obliterated evidence location, or, (2) a found perpetuated location?
- D) Describe any material discrepancy between the location of the corner as restored or reestablished and the location of that corner as previously restored or reestablished by distance and direction. Show the discrepancy on the plan view drawing under (a), above. Show the distances between the corner as previously restored or reestablished and (1) the corner as restored or reestablished, and (2) to at least 4 of the witness monuments shown on the drawing in (a), above.
- (E) Was the corner reestablished through lost corner proportionate methods? If so, show the method, including the directions and distances to other public land survey corners used as evidence or used for proportioning the corner location.

I, Donald Barnes, hereby certify that the corner location as identified by the corner code index was determined by me under my direction and control and that this U.S. Public Land Survey Monument Record is correct and complete to the best of my knowledge and belief.

seal

Number of included sheets 1

75 2000

A-E 7.08 REQUIREMENT

CORNER CODE X-23