



NE COR
SEC 23

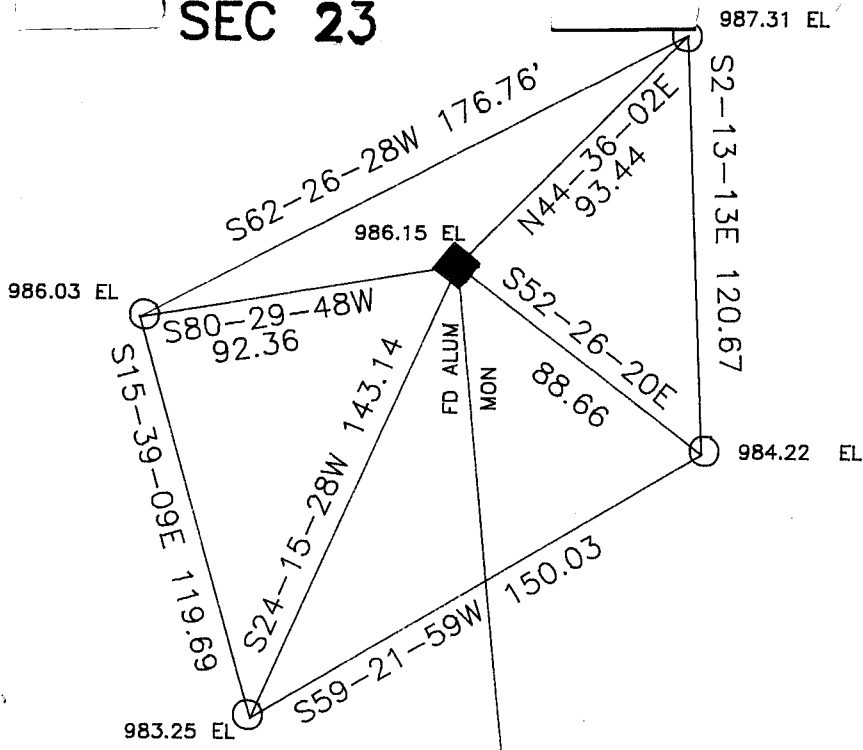


TWP PROJECT 2638.07
COMBS 2638.02
S1-02-48E 2638.07

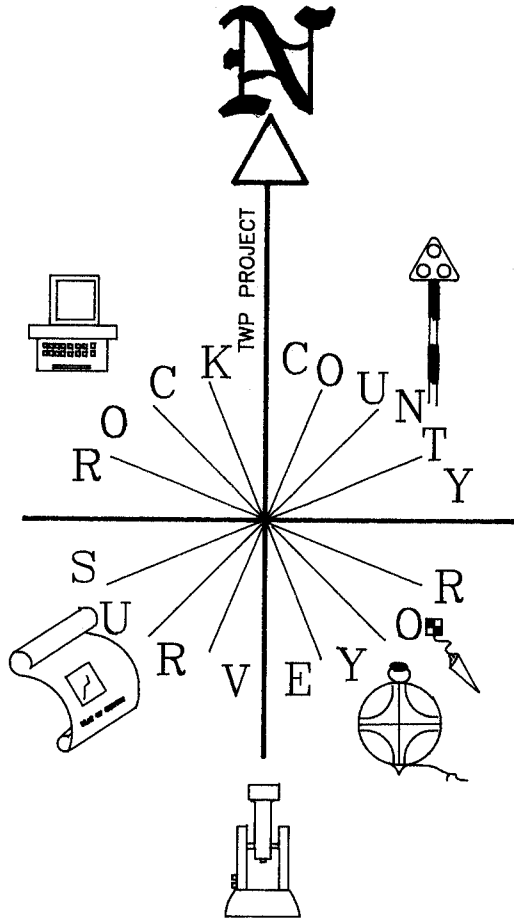

FB #2 PG 34

○ 3/4 X 24 REROD 15"
DEEP WITH MAGNET

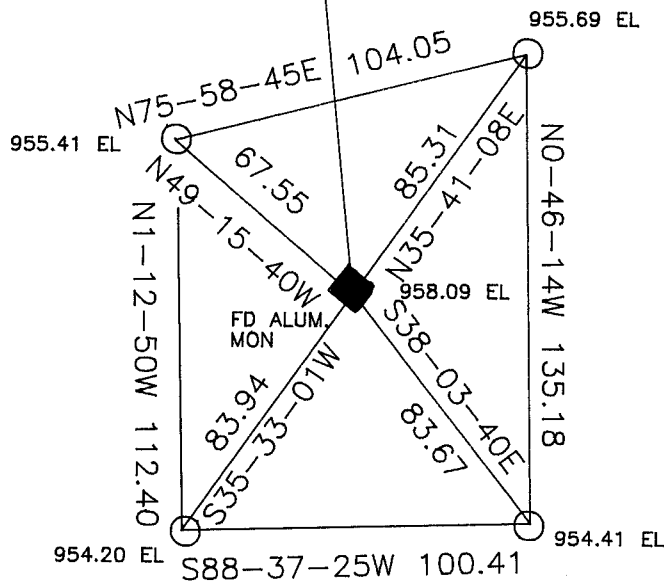

E 1/4
SEC 23

Donald Barnes
Dec 1, 1993

ROAD BEING CONSTRUCTED
ALONG SECTION LINE