## U.S.


## PUBLIC LAND SURVEY MONUMENT RECORD

For Public Land Survey Corners in:

WI ADMINISTRATIVE CODE A-E 7.08 REQUIREMENT

T.3 N., R. 14 E

CORNER CODE INDEX

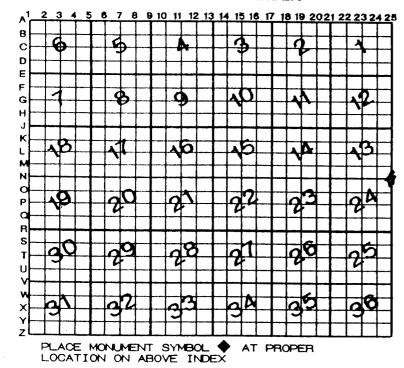

JOH N	STOWI	U_	TV	<b>V</b> P
ROCK	COUNTY	W	I	

IF AVAILABLE
ROCK COUNTY COORDINATES PERFERRED

North 261, 552.02 Elev. \_\_\_\_\_

Hor. Datum 1927 Vert. Datum 1929

voit. Batom 7197

LONGITUTE

GPS (X) \_

**LATITUDE** 

TRAVERSE (X)

\_ELLIPS. HT.

BASED ON THE FOLLOWING CONTROL:

**♦**CORNER MONUMENT

O WITNESS MONUMENT

(a)

A LETTER WAS SENT ON JULY 23, 2003 WITH THE FOLLOWING LANGUAGE. SINCE HE HASN'T RESUBMITTED ON THE CORRECT FORMS, HIS U.S. PUBLIC LAND SURVEY MONUMENT RECORD IS FILED AS:

MAP # [4770] IN SEC 24 T 3 N R [4E. PLAT OF SURVEY RECORDS.

DONALD BARNES, COUNTY SURVEYOR.

Dear Mr. Kreblin,

Thank you for the copies. In order to file them with the U.S. Public Land Survey Monument Records they need to be on the County's adopted form. I am sending you several blank forms to complete if you wish to file them with the U.S. Public Land Survey Monument Records. If not, I will file them with the plat of surveys.

BEARINGS ARE BASED ON:

Dunk! Laures 21/7/2004 FIELD BOOK \_\_\_\_\_PAGE #

SHEET \_\_\_\_\_ OF \_\_\_\_

SHOW A PLAN VIEW DRAWING DEPICTING THE CORNER MONUMENT AND SURROUNDING PHYSICAL FEATURES, INCLUDING THE EXCAVATION AREA AND DEPTH.

PLANNING & ZONING COMMITTEE ADOPTED THE ABOVE FORM ON 12/2/1982