

U.S. PUBLIC LAND SURVEY MONUMENT RECORD


For Public Land Survey Corners in the
T. 3 N., R. 10 E.

CORNER CODE INDEX

| | | | | | | | | | | | | | | | | | | | | | | | | | |
|---|----|----|----|----|----|----|----|----|----|----|----|----|----|----|----|----|----|----|----|----|----|----|----|----|----|
| | 1 | 2 | 3 | 4 | 5 | 6 | 7 | 8 | 9 | 10 | 11 | 12 | 13 | 14 | 15 | 16 | 17 | 18 | 19 | 20 | 21 | 22 | 23 | 24 | 25 |
| A | | | | | | | | | | | | | | | | | | | | | | | | | |
| B | | | | | | | | | | | | | | | | | | | | | | | | | |
| C | 6 | | | | | | | | | | | | | | | | | | | | | | | | |
| D | | 5 | | | | | | | | | | | | | | | | | | | | | | | |
| E | | | 4 | | | | | | | | | | | | | | | | | | | | | | |
| F | | | | 3 | | | | | | | | | | | | | | | | | | | | | |
| G | | | | | 2 | | | | | | | | | | | | | | | | | | | | |
| H | | | | | | | | | | | | | | | | | | | | | | | | | |
| I | 7 | | | | | | | | | | | | | | | | | | | | | | | | |
| J | | 8 | | | | | | | | | | | | | | | | | | | | | | | |
| K | | | 9 | | | | | | | | | | | | | | | | | | | | | | |
| L | | | | 10 | | | | | | | | | | | | | | | | | | | | | |
| M | | | | | 11 | | | | | | | | | | | | | | | | | | | | |
| N | | | | | | 12 | | | | | | | | | | | | | | | | | | | |
| O | 16 | | | | | | | | | | | | | | | | | | | | | | | | |
| P | | 17 | | | | | | | | | | | | | | | | | | | | | | | |
| Q | | | 18 | | | | | | | | | | | | | | | | | | | | | | |
| R | | | | 19 | | | | | | | | | | | | | | | | | | | | | |
| S | | | | | 20 | | | | | | | | | | | | | | | | | | | | |
| T | | | | | | 21 | | | | | | | | | | | | | | | | | | | |
| U | | | | | | | 22 | | | | | | | | | | | | | | | | | | |
| V | | | | | | | | 23 | | | | | | | | | | | | | | | | | |
| W | | | | | | | | | 24 | | | | | | | | | | | | | | | | |
| X | | | | | | | | | | 25 | | | | | | | | | | | | | | | |
| Y | | | | | | | | | | | 26 | | | | | | | | | | | | | | |
| Z | | | | | | | | | | | | 27 | | | | | | | | | | | | | |
| | | | | | | | | | | | | | 28 | | | | | | | | | | | | |
| | | | | | | | | | | | | | | 29 | | | | | | | | | | | |
| | | | | | | | | | | | | | | | 30 | | | | | | | | | | |
| | | | | | | | | | | | | | | | | 31 | | | | | | | | | |
| | | | | | | | | | | | | | | | | | 32 | | | | | | | | |
| | | | | | | | | | | | | | | | | | | 33 | | | | | | | |
| | | | | | | | | | | | | | | | | | | | 34 | | | | | | |
| | | | | | | | | | | | | | | | | | | | | 35 | | | | | |
| | | | | | | | | | | | | | | | | | | | | | 36 | | | | |

PLACE MONUMENT SYMBOL (◆) AT PROPER LOCATION ON ABOVE INDEX

EXAMPLE

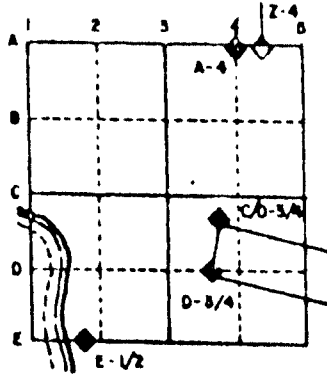

MAGNOLIA TWP
ROCK COUNTY WI


IF AVAILABLE
STATE PLANE COORDINATES

North (Y) _____ Eleve. (Z) _____
 East (X) _____ Zone _____
 Hor. Datum _____ Vert. Datum _____

◆ CORNER MONUMENT

○ WITNESS MONUMENT

BEARINGS ARE BASED ON:

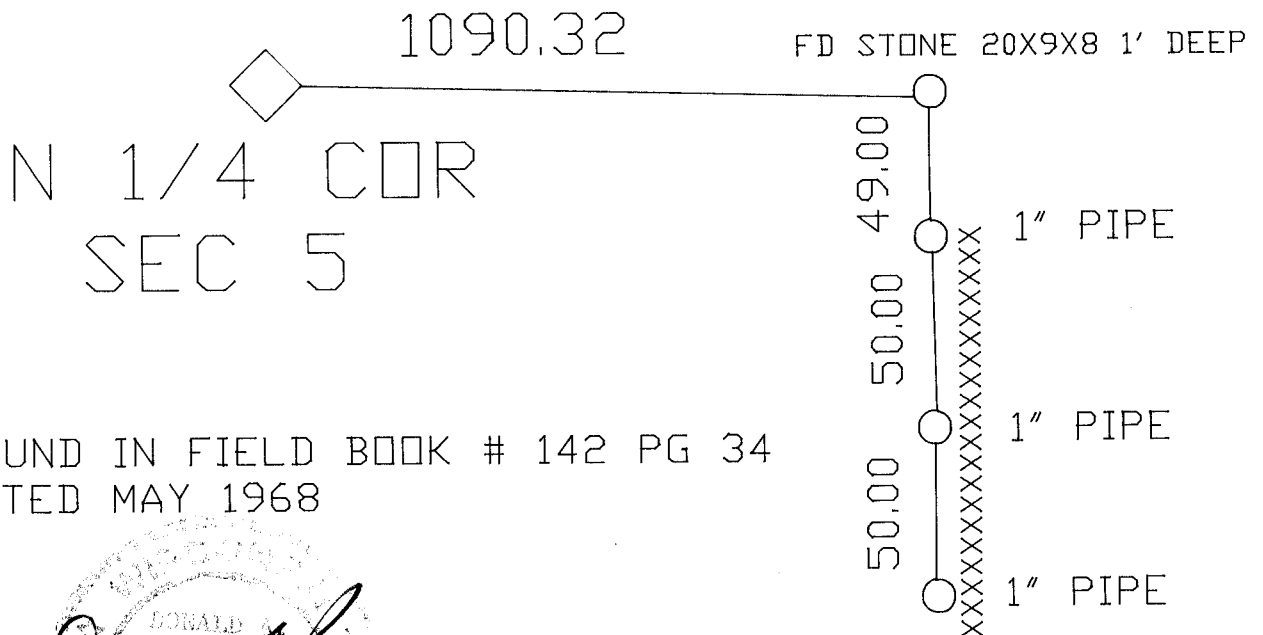

FOUND IN FIELD BOOK # 142 PG 34
DATED MAY 1968

Donald Brunas
 DONALD BRUNAS
 SURVEYOR
 JANSVILLE
 WI.
 LAND SURVEY CO.

MICROFILMED

SHEET _____ OF _____

CORNER CODE: AS