Paper weight- 32# 25% Rag Ledger (minimum)


Black nonfading introduped

U.S.

SURVEY TUBLIC RECORD MONUMENT

For	Public	Land	Survey	Corners	in	the
	Τ. ∡	<u>_N.,</u>	R. 14	Corners E		

CORNER CODE INDEX

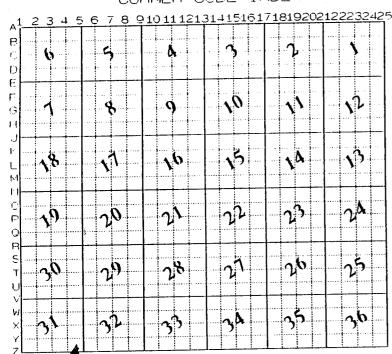

CLINT	TWI	
ROCK	COUNTY	WI

ROCK COUNT	TE AVAILABLE Y COORDINATES PERFERRED	
North	Elev.	•
East	- contract with deliberation and deliver a war of the co	
Hor. Datum	Vert. Datum	
GPS (%)	TRAVERSE (X)	
BASED ON THE FOL	LOWING CONTROL:	

PLACE MONUMENT SYMBOL & LOCATION OH ABOVE INDEX

CORNER MONUMENT

O WITHESS MONUMENT

BEARINGS ARE BASED ON:_

(a)

FIELD BOOK PAGE # SHOW A PLAN VIEW PRANTING DEPICTING THE CORNER MOLUMENT AND SUPPOLIDING PHYSICAL FEATURES, INCLUDING THE EXCAVAT THE POLLOWING CHARACTERISTICS: 11 HAVE A LEAST TWO PRIDETERMINED BREAK-OFF POLITIS. 21 IF BROKER LEAVE A PERHANE THE POLLOWING CHARACTERISTICS: 11 HAVE A LEAST TWO PRIDETERMINED BREAK-OFF POLITIS. 21 IF BROKER LEAVE A PERHANE 30 MUST BE EXTENDED. 41 MINIMAM MAY BE USED IT AREAS WHERE GROUND WATER IS WITHIN DOE FOOT OF THE SUPPLY. 42 MINIMAM MAY BE USED IT AREAS WHERE GROUND WATER IS WITHIN ONE FOOT OF THE SUPPLY. 43 MINIMAM MAY BE USED IT AREAS WHERE GROUND WATER IS WITHIN ONE FOOT OF THE SUPPLY. 44 MINIMAM MAY BE USED IT AREAS WHERE GROUND WATER IS WITHIN ONE FOOT OF THE SUPPLY. 45 MINIMAM MAY BE USED IT AREAS WHERE CROWNED WATER IS WITHIN ONE FOOT OF THE SUPPLY. 46 MINIMAM MAY BE USED IT AREAS WHERE GROUND WATER IS WITHIN ONE FOOT OF THE SUPPLY. 47 MINIMAM MAY BE USED IT AREAS WHERE CROWNED WATER IS WITHIN ONE MINIMAM MAY BE USED. 48 MINIMAM MAY BE USED IT AREAS WHERE CROWNED WATER IS WITHIN ONE MINIMAM MAY BE USED. 48 MINIMAM MAY BE USED IT AREAS WHERE CROWNED WATER IS WITHIN ONE FOOT OF THE SUPPLY. 49 MUST BE EXCENDED.	OR AN EXIS	TING OUT LINE	ESTOLE, AN	AN IRON PIPE 1 1/2 ×	
DURABLE, DISTINCT MONUTER MAY BE USED. COMBINE SHALL BE DESCRIBE THE CORNER AND THE WITHESS MONUMENTS. STONE, IRON OR OTHER EQUÂLLY DURABLE MATERIAL E-CEPT WOOD. DESCRIBE THE CORNER AND THE WITHESS MONUMENTS.			_{or} 2	•	
IN AURILIAS & ZONILIAS COPRETE ADOPTED THE ABOVE FORM ON 12/2/1982	SHEET	<i>-</i> '	OF		

PLAINING & ZONING COMMITTEE ADOPTED THE ABOVE FORM ON 12/2/1982 WI ADMINISTRATIVE CODE A-E 7.08 REQUIREMENT

CORNER CODE

4017

NW3 T46N R3E ILL507R3

- (B) Describe any record evidence, monument evidence, occupational evidence, testimonial evidence or any other material evidence you
- considered, and whether the monument was found or placed. 1838 SPALDING FIELD NOTES PG 855 & 856 ORIGINAL SURVEYOR. INTERSECTED THE NORTH BOUNDARY OF THE STATE OF ILL. 1152.36' WEST OF THE CORNER TO SECTIONS 31 & 32 T1N R14E OF 4TH PM. AT SAID INTERSECTION SET A POST FOR CORNERS SECTION 3 & 4 T46N R3E. MEASURED CHAIN COMPARED WITH THE STANDARD CHAIN & LIST IT TO BE A HALF INCH TOO LONG. MAKE IT OF THE PROPER LENGTH.
- C) Was the corner restored through acceptance of (1) an obliterated evidence location, or, (2) a found perpetuated location?
- Describe any material discrepancy between the location of the corner as restored or reestablished and the location of that corner as previously restored or reestablished by distance and direction. Show the discrepancy on the plan view drawing under (a), above. Show the distances between the corner as previously restored or reestablished and (1) the corner as restored or reestablished, and (2) to at least 4 of the witness monuments shown on the drawing in (a), above.
- (E) Was the corner reestablished through lost corner proportionate methods? If so, show the method, including the directions and distances to other public land survey corners used as evidence or used for proportioning the corner location.

I, Donald Barnes, hereby certify that the corner points as identified by the corner code index were, in a field survey on, , established, re-established, monumented, re-monumented, recovered or restored as expressed below and in conformance with the regulations and rules as required in the current manual of survey instructions of the United States Department of Interior, Bureau of Land Management.

Donald Baines
7/13/95

EMBOSS LAND SURVEYOR SEAL

COUNTY SURVEYOR FILING DATA Date of computer entry____ Date microfilmed Number of included sheets CORNER CODE

24/5

ILLINOIS ORIGINAL GOVERNMENT FIELD NOTES T46N R2&3E CERTIFICATE DEC 29,1836

D.A. SPAULDING WILLIAM TOP JAMES THOMAS R. WALLER

HENRY CHANDLER

DL CH CHAINMAN CHAINMAN

FLAGMAN AXE MAN

ALL CORNER POSTS WERE INSERTED 2' INTO A HOLE DUG IN THE GROUND WITH AN AXE & SPADE THROUGH THE FROST & THEY WERE SECURELY RAMMED IN WITH EARTH. THE STONES USED FOR CORNERS WERE OBTAINED AT DIFFERENT QUARRIES IN THE ?? AND WERE SET 1 1/2 THEIR LENGTH IN THE GROUND & ON ALL THE N/S LINES, THEY WERE SET THE WEST SIDE OF THE POSTS & EDGES FACING N/S AND ON THE E/W LINES THEY WERE SET THE NORTH SIDE OF THE POSTS & EDGES FACING E & W.

THE SAID POSTS WERE OF THE MOST DURABLE WOOD THAT COULD BE HAD IN THE LAND GENERALLY BURR OAK. THE SECTION POSTS WERE 5' LONG & WERE NOT LESS THAN 5" IN DIA., THAT THEY WERE NEATLY SQUARED AT TOP & THEN PLACED WITH THE CORNERS TO THE CARDINAL POINTS. (CONTINUES WITH OTHER STATEMENTS).

PAGE 857. DEC 26, 1838 MEASURED CHAIN COMPARED WITH THE STANDARD CHAIN & LIST IT TO BE A HALF INCH TOO LONG. MAKE IT OF THE PROPER LENGTH.