

# U.S. PUBLIC LAND SURVEY MONUMENT RECORD

For Public Land Survey Corners in:

WI ADMINISTRATIVE CODE A-E 7.08 REQUIREMENT

T. 3 N., R. 14 E

CORNER CODE INDEX

A	1	2	3	4	5	6	7	8	9	10	11	12	13	14	15	16	17	18	19	20	21	22	23	24	25
B	6																								
C		5																							
D			A																						
E				3																					
F					2																				
G						1																			
H	1																								
I		8																							
J			9																						
K				10																					
L					11																				
M	18					9																			
N		17					16																		
O			18					15																	
P				19					14																
Q					20					13															
R						21																			
S							22																		
T								23																	
U									24																
V										25															
W											26														
X												27													
Y													28												
Z														29											
															30										
																31									
																	32								
																		33							
																			34						
																				35					
																					36				

Johnstown TWP  
**ROCK COUNTY WI**

IF AVAILABLE  
ROCK COUNTY COORDINATES PREFERRED

North \_\_\_\_\_ Elev. \_\_\_\_\_

East \_\_\_\_\_

Hor. Datum \_\_\_\_\_ Vert. Datum \_\_\_\_\_


LATITUDE \_\_\_\_\_ ELLIPS. HT. \_\_\_\_\_

LONGITUDE \_\_\_\_\_

GPS (X) \_\_\_\_\_ TRAVERSE (X) \_\_\_\_\_

BASED ON THE FOLLOWING CONTROL:

PLACE MONUMENT SYMBOL  AT PROPER LOCATION ON ABOVE INDEX

 CORNER MONUMENT       WITNESS MONUMENT

BEARINGS ARE BASED ON: Assumed datum

WI. HEIGHT  
MOD STA.  
(JOHNSTOWN  
CENTER GPS)

N1°01'26"W  
112.62'

N16°17'25"W  
89.89'

S47°15'18"E  
80.20'

C.T.H.  
"KK"

N46°36'35"E  
46.35'

FOUND PK MONUMENT  
OVER BELIEVED ALUMINUM  
MONUMENT (STRONG MAGNETIC  
ATTRACTION) PK CHECKED  
COUNTY COORDINATES.

N41°23'26"E  
35.09'

S41°11'16"E  
53.65'

S1°18'24"E  
72.24'

FENCE

16.8'±

BIT. PVMT.

60.20'  
N76°30'06"W



FIELD BOOK \_\_\_\_\_ PAGE # \_\_\_\_\_

SHEET 1 OF 2

SHOW A PLAN VIEW DRAWING DEPICTING THE CORNER MONUMENT AND SURROUNDING PHYSICAL FEATURES, INCLUDING THE EXCAVATION AREA AND DEPTH.

PLANNING & ZONING COMMITTEE ADOPTED THE ABOVE FORM ON 12/2/1982

CORNER CODE J-9

(B) Describe any record evidence, monument evidence, occupational evidence, testimonial evidence or any other material evidence you considered, and whether the monument was found or placed.

Fd. PK Masonry Nail. Got very strong magnetic attraction. Believe aluminum monument to be below PK. PK nail checked county coordinates. Set 3 reference monuments.


(C) Was the corner restored through acceptance of (1) an obliterated evidence location, or, (2) a found perpetuated location?

Found perpetuated location.

(D) Describe any material discrepancy between the location of the corner as restored or reestablished and the location of that corner as previously restored or reestablished by distance and direction. Show the discrepancy on the plan view drawing under (a), above. Show the distances between the corner as previously restored or reestablished and (1) the corner as restored or reestablished, and (2) to at least 4 of the witness monuments shown on the drawing in (a), above.

(E) Was the corner reestablished through lost corner proportionate methods? If so, show the method, including the directions and distances to other public land survey corners used as evidence or used for proportioning the corner location.

I, Steven Lathrop hereby certify that the corner location as identified by the corner code index was determined by me under by direction and control and that this U.S. Public Land Survey Monument Record is correct and complete to the best of my knowledge and belief.

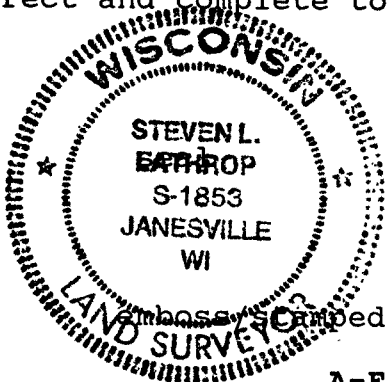

*Steven Lathrop*

Oct. 15, 2008

Number of included sheets 2

CORNER CODE

J-9