
PUBLIC LAND U.S. SURVEY MONUMENT RECORD

For Public Land Survey Corners in:

WI ADMINISTRATIVE CODE A-E 7.08 REQUIREMENT

T. 3N., R. 4E

CORNER CODE INDEX

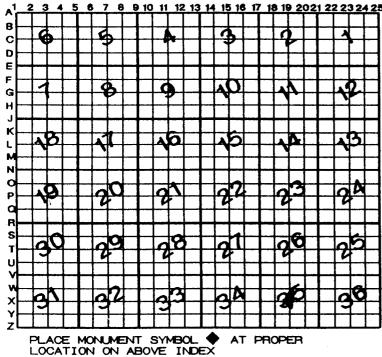

JOHN	STOWA	twp
ROCK	COUNTY	WI

IF AVAILABLE ROCK COUNTY COORDINATES PERFERRED

North	Elev
East	
Hor. Datum	Vert. Datum
LATITUDE	ELLIPS. H
LONGITUTE	
GPS (X)	TRAVERSE (X)
BASED ON THE	FOLLOWING CONTROL:

CORNER MONUMENT

WITNESS MONUMENT

ÿ O BEARINGS ARE BASED

(a)

							OF	/
FIELD	BOOK	PAGE # _				SHEET	OF	/
SHOW	A PLAN VIEW	DRAWING DE	EPICTING THE	CORNER	MONUMENT	AND SURRO	UNDING	
PHYSIC	AL FEATURES,	INCLUDING 1	THE EXCAVAT	ION AREA	AND DEPTH	1 .		
DI ANNIN	C . 70NING COM	MATTEE ADOPT	EN THE ABOVE	FORM ON 1	0/0/1000			

J08618

(B)Describe any record evidence, monument evidence, occupational evidence, testimonial evidence or any other material evidence you considered, and whether the monument was found or placed.

1867 LOCKE VOL 1 PG 300 SET IRON WOOD STAKE WITH LIMESTONE ON SOUTH & HARD HEAD ON NORTH, EAST, & WEST. 2560.97 VAR 4-48 TO W 1/4 COR SEC 31, 2640 VAR 4-48 TO E 1/4 COR SEC 31, & VAR 6-50 FOR N/S 1/4 LINE.

SEARCHED & FOUND NOTHING ON PAVEMENT SURFACE. PAVEMENT WILL BE GROUND OUT & ROAD RESURFACED.

- C) Was the corner restored through acceptance of (1) an obliterated evidence location, or, (2) a found perpetuated location?
- D) Describe any material discrepancy between the location of the corner as restored or reestablished and the location of that corner as previously restored or reestablished by distance and direction. Show the discrepancy on the plan view drawing under (a), above. Show the distances between the corner as previously restored or reestablished and (1) the corner as restored or reestablished, and (2) to at least 4 of the witness monuments shown on the drawing in (a), above.
- (E) Was the corner reestablished through lost corner proportionate methods? If so, show the method, including the directions and distances to other public land survey corners used as evidence or used for proportioning the corner location.

I, Donald Barnes, hereby certify that the corner location as identified by the corner code index was determined by me under my direction and control and that this U.S. Public Land Survey Monument Record is correct and complete to the best of my knowledge and belief.

seal

-26,2000

emboss

Number of included sheets 1

CORNER CODE X-19

A-E 7.08 REQUIREMENT