

PLAT AND RECORD

93


COUNTY BUILDING
IN CITY OF BELOIT
Township

Of a Survey on Section 36 T 2 R 12 E. of the 4 P. M. in Rock Township

Rock County, Wisconsin, made April the 8 1920

I hereby certify that the following is a correct record of said survey as made by me.

A. A. Batterman
County Surveyor.

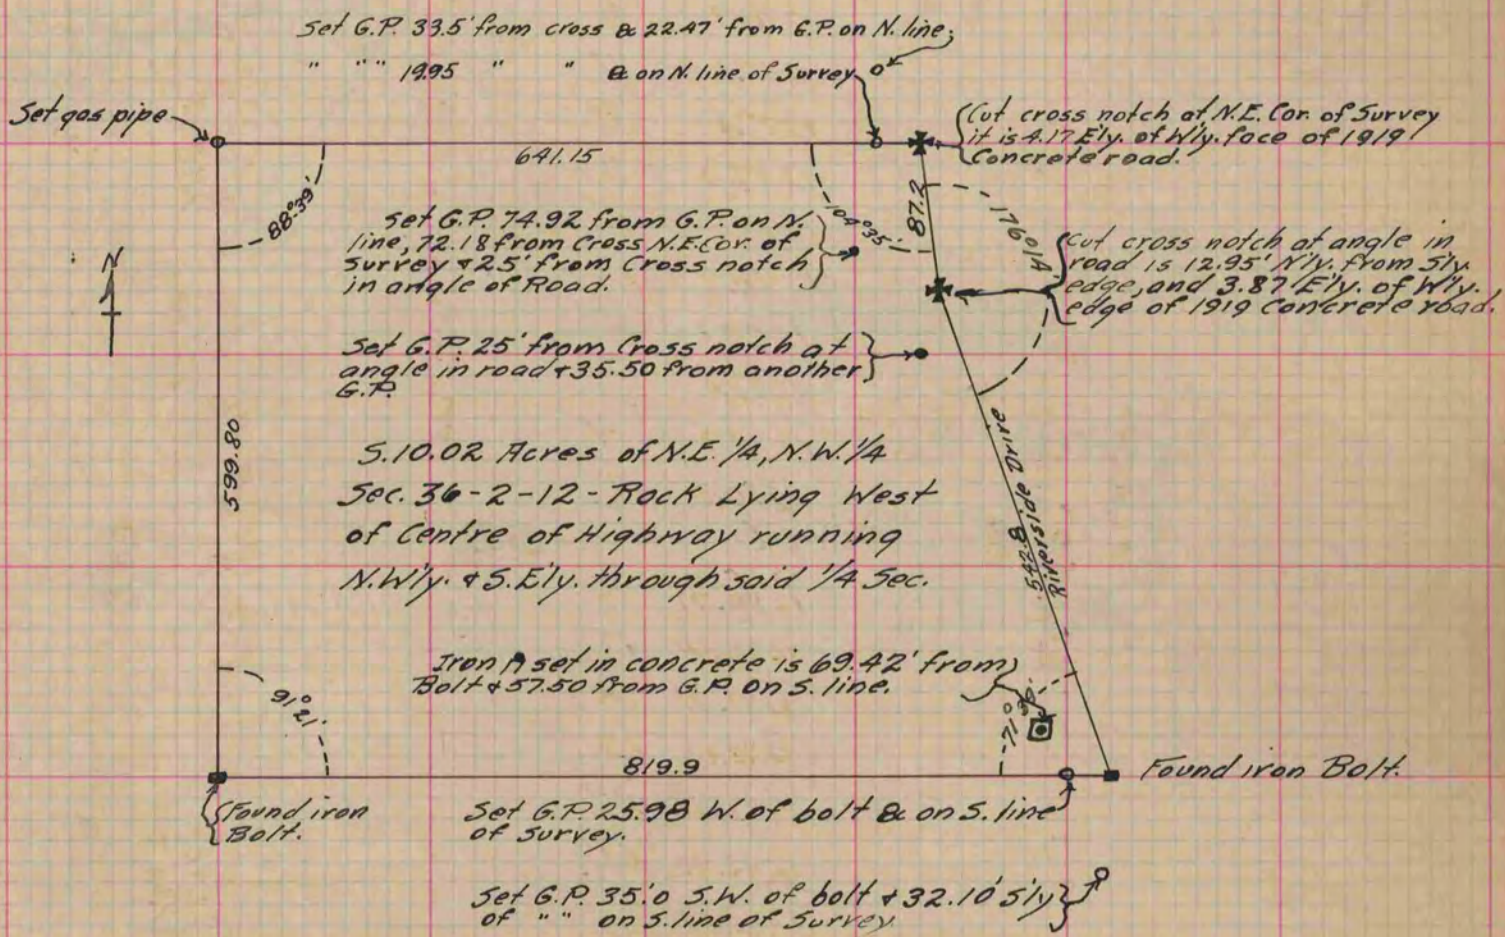

326 for M.E. Kenney.