

PLAT AND RECORD

73


COUNTY BUILDING
IN CITY OF BELOIT

Of a Survey on Section 13 T 1 R 13 E. of the 4 P. M. in Turtle Township

Rock County, Wisconsin, made August the 20th 1914

I hereby certify that the following is a correct record of said survey as made by me.

(Signed) R. R. Caldwell
R. H. B. County Surveyor.

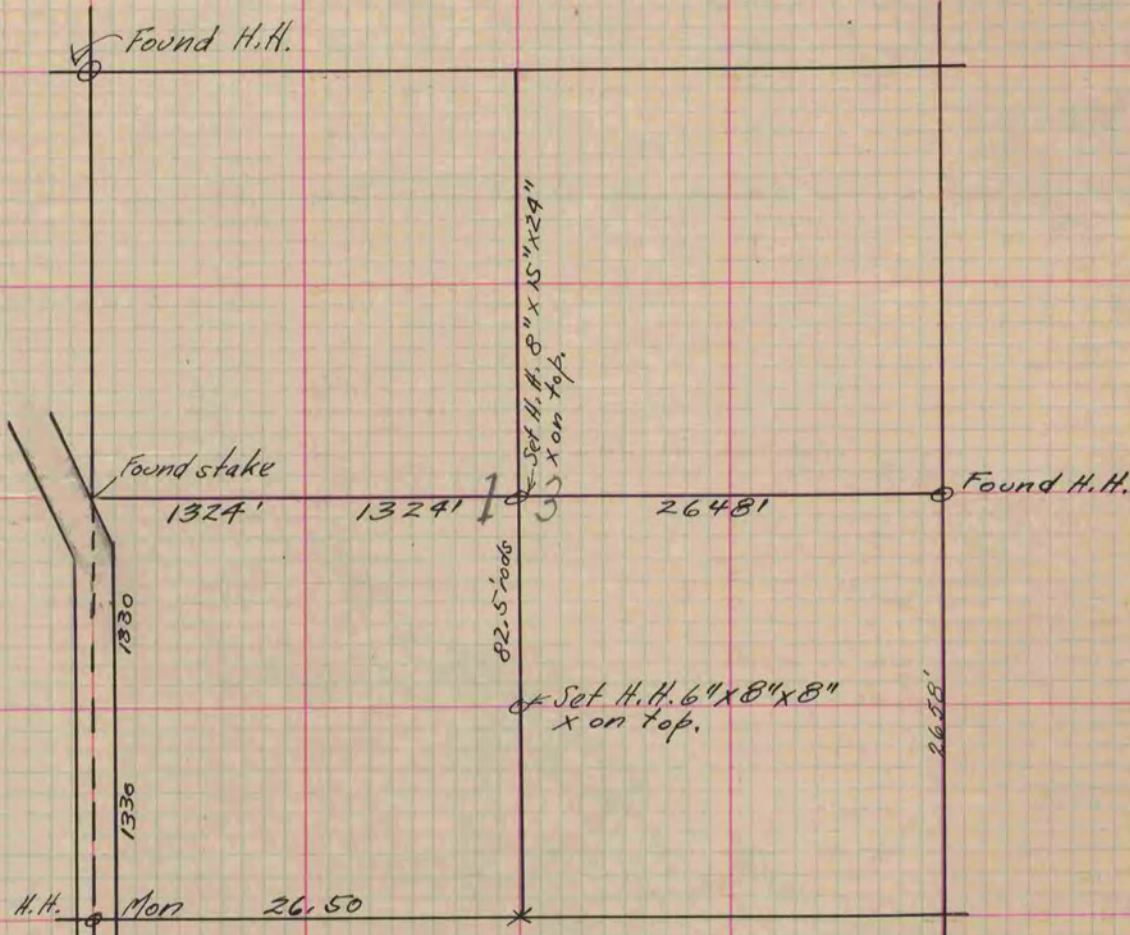

Note:— The line surveyed on the center line of Sect. is according to deed held by Chas. and Jas. Kelly 82.5 rods long.