


# PLAT AND RECORD

Of a Survey on <sup>the N.W. 1/4</sup> Section 17 T 3 R 10 E. of the 4 P. M. in Magnolia Township  
 Rock County, Wisconsin, made December the 21<sup>st</sup> 1855

I hereby certify that the following is a correct record of said survey as made by me.

COUNTY BUILDING  
 IN CITY OF BELOIT

(Signed) Joseph Church  
JMB County Surveyor.

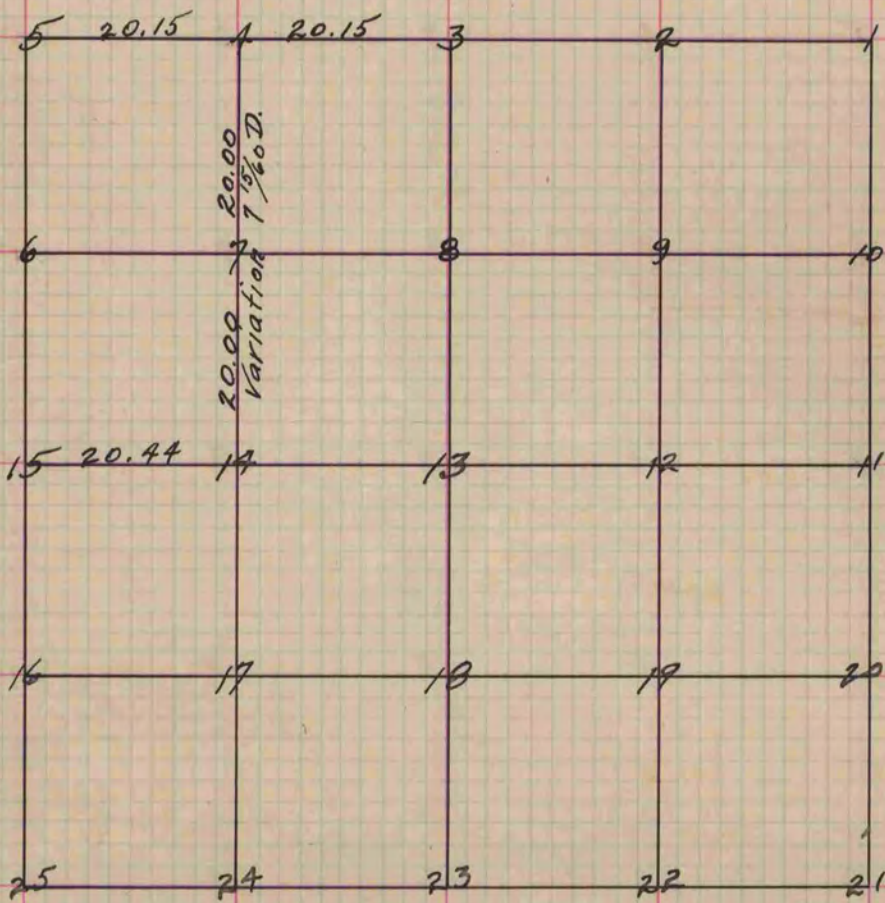

From Fig. 15 to 11 over runs 1770 found stake by stumps marked  
 Fig. 14 Buried stone  
 " 7 Bur. O. 20 S. 57 1/2 W. 55  
 Br. O. 18 S. 21 E. 69  
 " 4 W. O. 20 N. 63 W. 30  
 N. O. 24 N. 13 E. 60  
 " 6 see preceding page marked Fig 10  
 Copied from Page 57 Vol. 1 Original County Surveyor's Record.