

# PLAT AND RECORD

Of a Survey on Section 10 T 2 R 10 E. of the 4 P. M. in Spring Valley Township  
Rock County, Wisconsin, made February the 12<sup>th</sup> 1856

I hereby certify that the following is a correct record of said survey as made by me.

COUNTY BUILDING  
IN CITY OF БЕЛОIT

(Signed) Joseph Church  
JMB

County Surveyor.

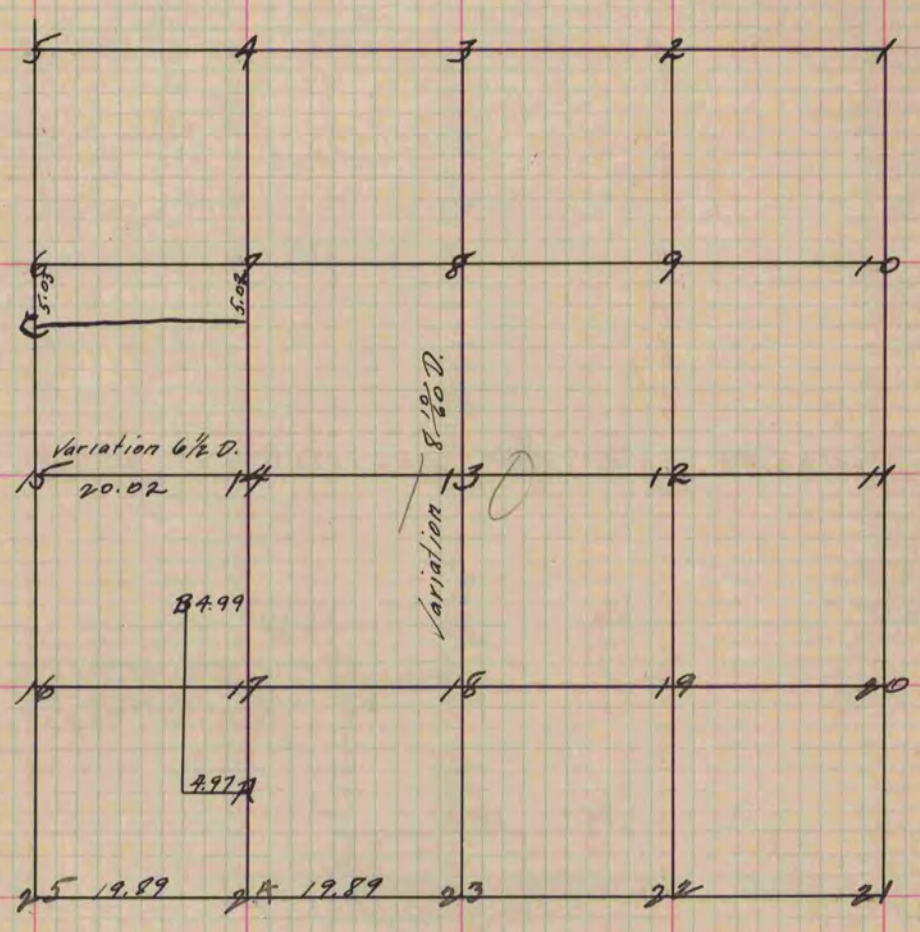


Fig. 24 Br. O. 18 N. 15 W. 75  
 Letter A Br. O. 14 S. 88 W. 34  
           16 N. 51 1/2 W. 45  
 " B Br. O. 18 N. 73 W. 120  
       Br. O. 14 N. 36 E. 90  
 C. Br. O. 12 N. 73 W. 57

Copied from Page 58 Vol. 1 Original County Surveyors Record.