

# PLAT AND RECORD

Of a Survey on Section 17 T 4 R 10 E. of the 4 P. M. in Union Township

Rock County, Wisconsin, made March the 5<sup>th</sup> 1856

I hereby certify that the following is a correct record of said survey as made by me.

COUNTY BUILDING  
IN CITY OF БЕЛОIT

(Signed) Joseph Church  
RMB

County Surveyor.

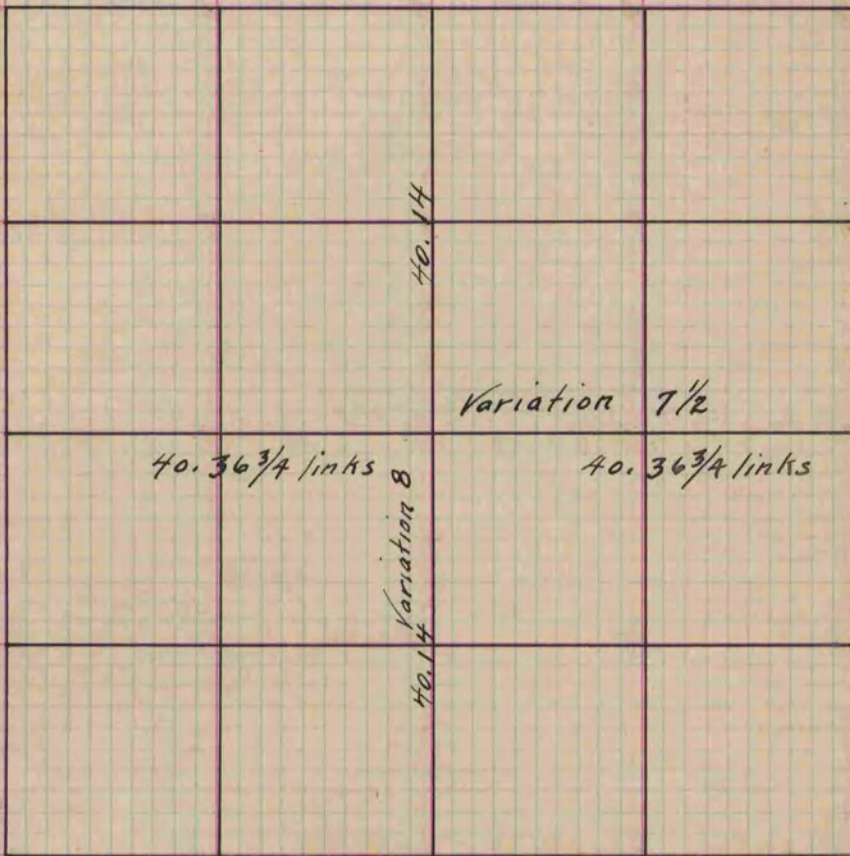


Fig. 13 Represents the Centre of the Section

Wit. to Fig. 13 Bro. 0. 10 N. 40 W. 190

" " 20 N. 59 W. 213

Copied from Page 60 Vol. 1 Original County Surveyor's Record.