

# PLAT AND RECORD

Of a Survey on Section 8 T 4 R 10 E. of the 4 P. M. in Union Township


Rock County, Wisconsin, made March the 4<sup>th</sup> & 5<sup>th</sup> 1956

I hereby certify that the following is a correct record of said survey as made by me.

COUNTY BUILDING  
IN CITY OF BELOIT

(Signed) Joseph Church  
RMB

County Surveyor.

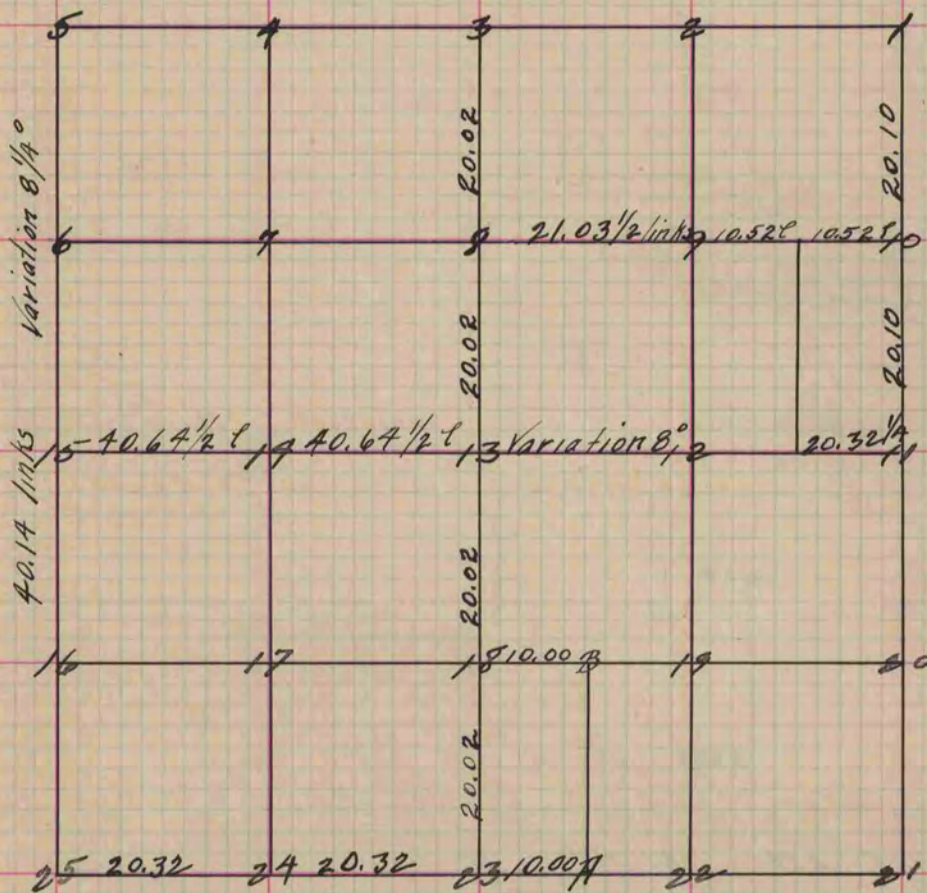

- Fig. 17 Wit. W.O. 36 S. 2 1/2 W. 27  
30 N. 51 E. 125
- " 24 Br. O. 20 S. 3 1/2 W. 63  
" O. 24 S. 57 W. 115
- " 8 " " 20 N. 18 W. 84 1/2  
24 N. 73 E. 169
- " 10 W. O. 30 N. 25 1/2 E. 63  
36 S. 11 W. 141 1/2
- " 9 Br. O. 12 N. 47 E. 22 1/2  
24 S. 3 E. 51
- " 13 Stake in Marsh

Fig. 12 Br. O. 12 S. 27 1/2 W. 82 1/2 Br. O. 20 S. 32 E. 106

Copied from Page 57 Vol. Original County Surveyor's Record