

PLAT AND RECORD

5


Of a Survey on Section 15 T 3 R 11 E. of the 4 P. M. in CENTER Township
Rock County, Wisconsin, made MAY the 14 1974

I hereby certify that the following is a correct record of said survey as made by me.

COUNTY BUILDING
IN CITY OF BELOIT

County Surveyor.

THE GEO. D. BARNARD COMPANY, ST. LOUIS

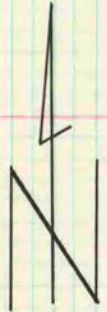

AT N.E. COR. SEC. 15-3-11 CENTER, DUG AND FD. NOTHING
SET ALUM. MON. AND REF. FOLLOWING TRAVERSE

5-14-74 M.L. J.L. R.L.

