

PLAT AND RECORD



31
Bel

Of a Survey on Section 13 T 3 N. R. 13 E. of the 4 P. M. in HARMONY Township
Rock County, Wisconsin, made JUNE the 21st 1973


I hereby certify that the following is a correct record of said survey as made by me.
**COUNTY BUILDING
IN CITY OF BELoit**

Hugh J. See
County Surveyor.

TM GEO. B. BARBARO COMPANY, ST. LOUIS

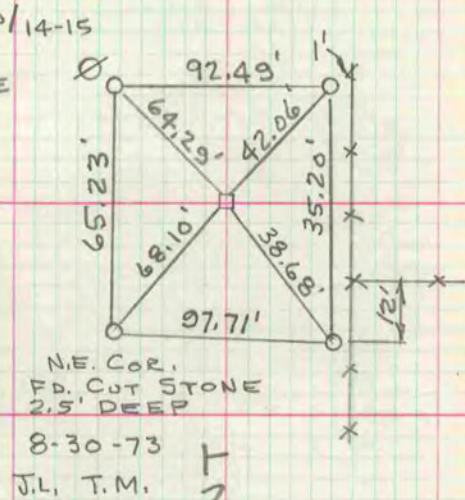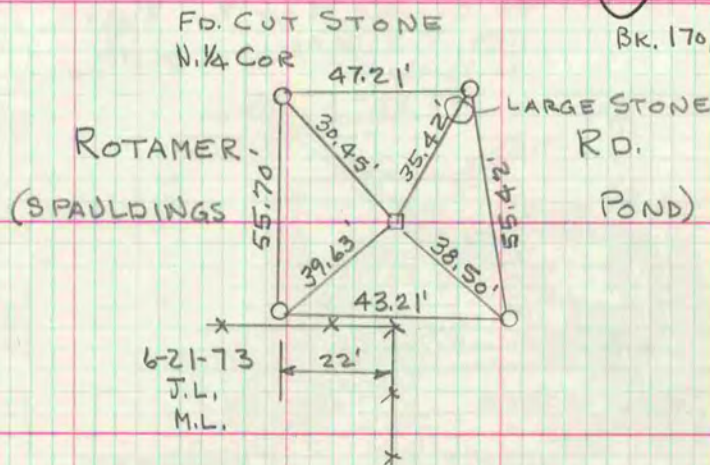

TARRANT

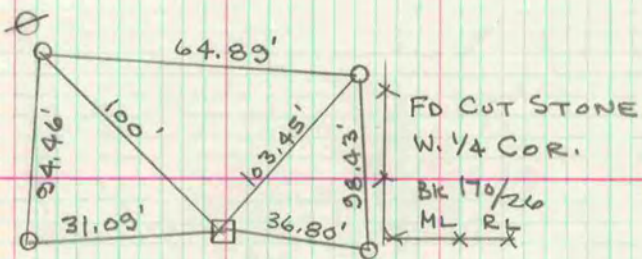

MILTON-
SHOPIERE