

# PLAT AND RECORD

COUNTY BUILDING  
IN CITY OF BELOIT  
Township


Reference to Monuments  
Of a Survey on Sections 11, 12, 13 & 14 T 2 R 12 E. of the 4 P. M. in Rock

Rock County, Wisconsin, made October the 21-22-23 1919

I hereby certify that the following is a correct record of said survey as made by me.

*R. H. Batterman*

County Surveyor.

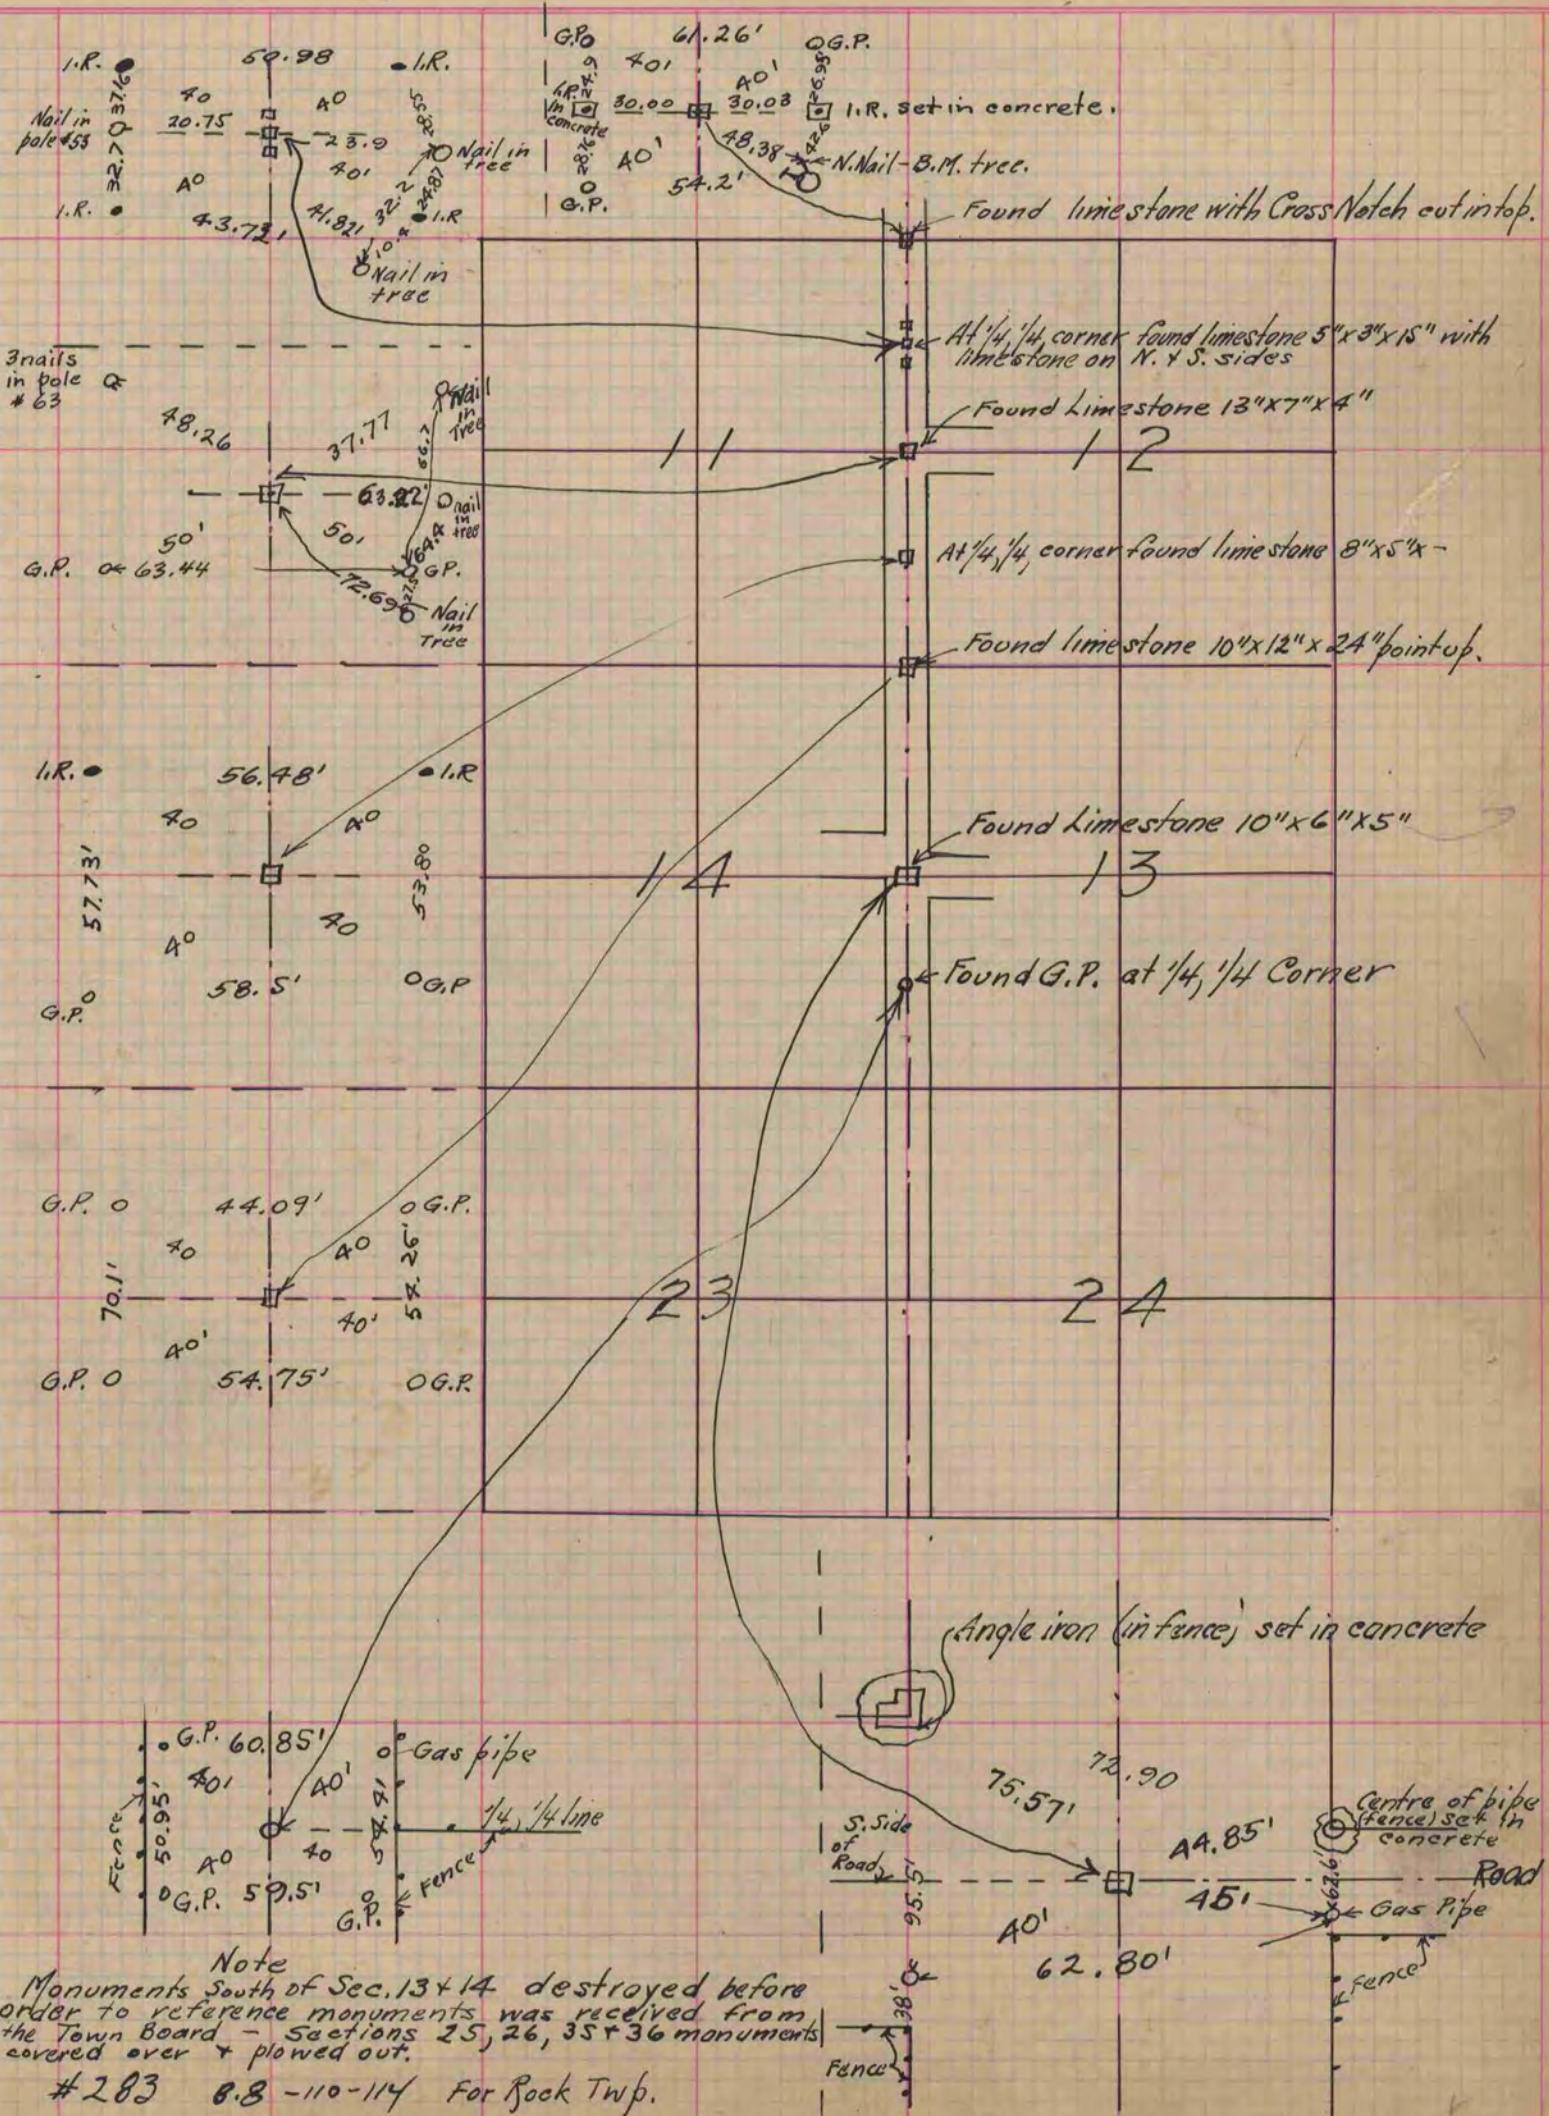

Note  
Monuments south of Sec. 13 & 14 destroyed before  
order to reference monuments was received from  
the Town Board - Sections 25, 26, 35 & 36 monuments  
covered over & plowed out.  
#283 8.8-110-114 For Rock Twp.