

PLAT AND RECORD

Of a Survey on Section 21 T 4 R 10 E. of the 4 P. M. in Union Township

Rock County, Wisconsin, made April the 10th 1857

I hereby certify that the following is a correct record of said survey as made by me.

COUNTY BUILDING
IN CITY OF БЕЛОIT

(Signed) Joseph Church

County Surveyor.

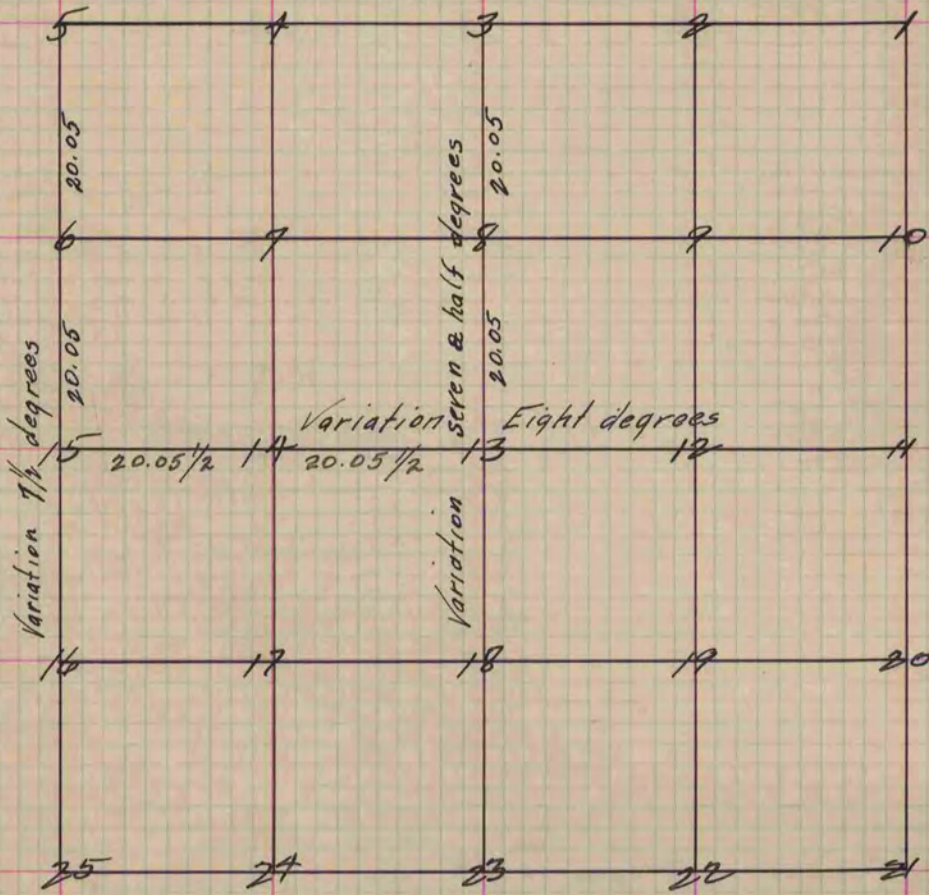


Fig. 13 Stake standing in the Creek N. side.

No bearings

" 15 Government post not found, divided distance

Marked stake stuck in the Marsh

No bearings.

Copied from Page 71 Vol. One Original County Surveyors Record.