

# PLAT AND RECORD

Of a Survey on Section 6 T 3 R 13 E. of the 4 P. M. in Harmony Township


Rock County, Wisconsin, made February the 4<sup>th</sup> 1859

I hereby certify that the following is a correct record of said survey as made by me.

COUNTY BUILDING  
IN CITY OF BELOIT

(Signed) Edward Ruger  
RMB County Surveyor.

Made for J. B. Crosby and H. Dillenbeck.  
Distances given in chains.  
Variations marked on the lines.

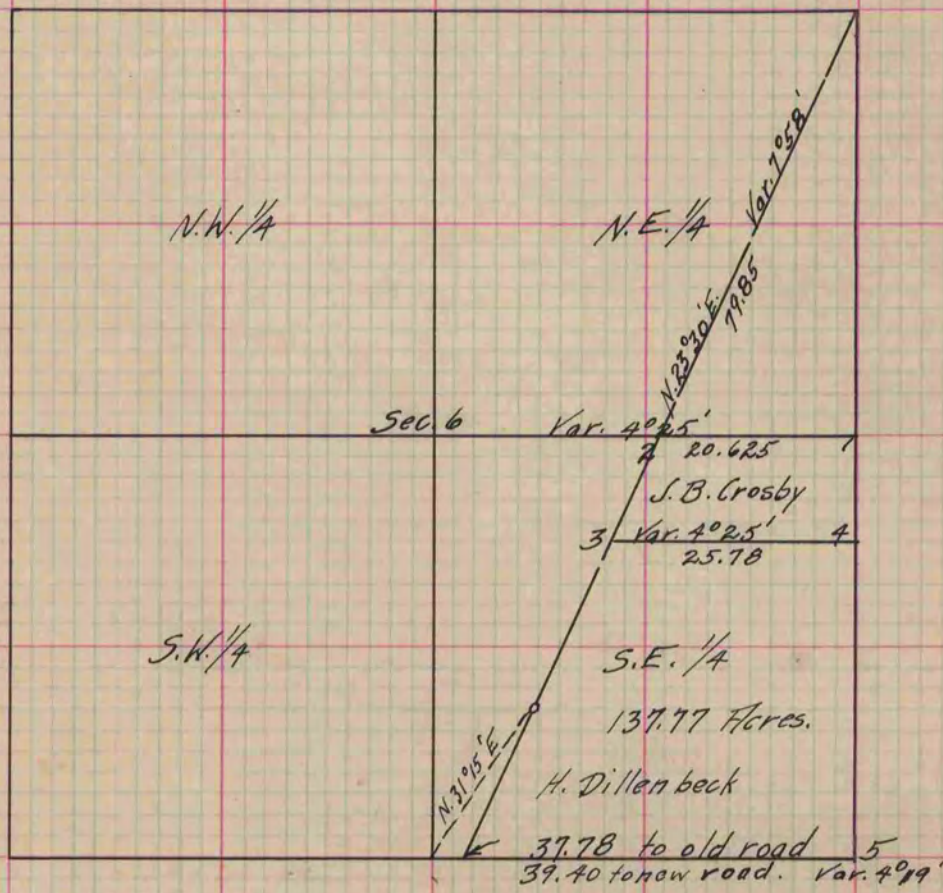

- Fig. 1, 4 & 5 the same as those in Sec. 5 over leaf
- " 2 Burr Oak 10 S. 21°05' E. 43
- " " " " 13 N. 57°35' E. 143
- " 3 Dry Oak Stump 1 foot high with 3 hacks in back
- " " " " N. 8°40' W. 133 3/4
- " " Burr Oak 8 S. 64°40' E. 143 Var. 4°25'

Copied from P. 99 Vol. one Original County Surveyor's Record