

# PLAT AND RECORD

Of a Survey on Section 34 T 2 R 12 E. of the 4 P. M. in Rock Township

Rock County, Wisconsin, made June the 11<sup>th</sup> 1858

I hereby certify that the following is a correct record of said survey as made by me.

COUNTY BUILDING  
IN CITY OF BELOIT

(Signed) Joseph Church  
JAC

County Surveyor.

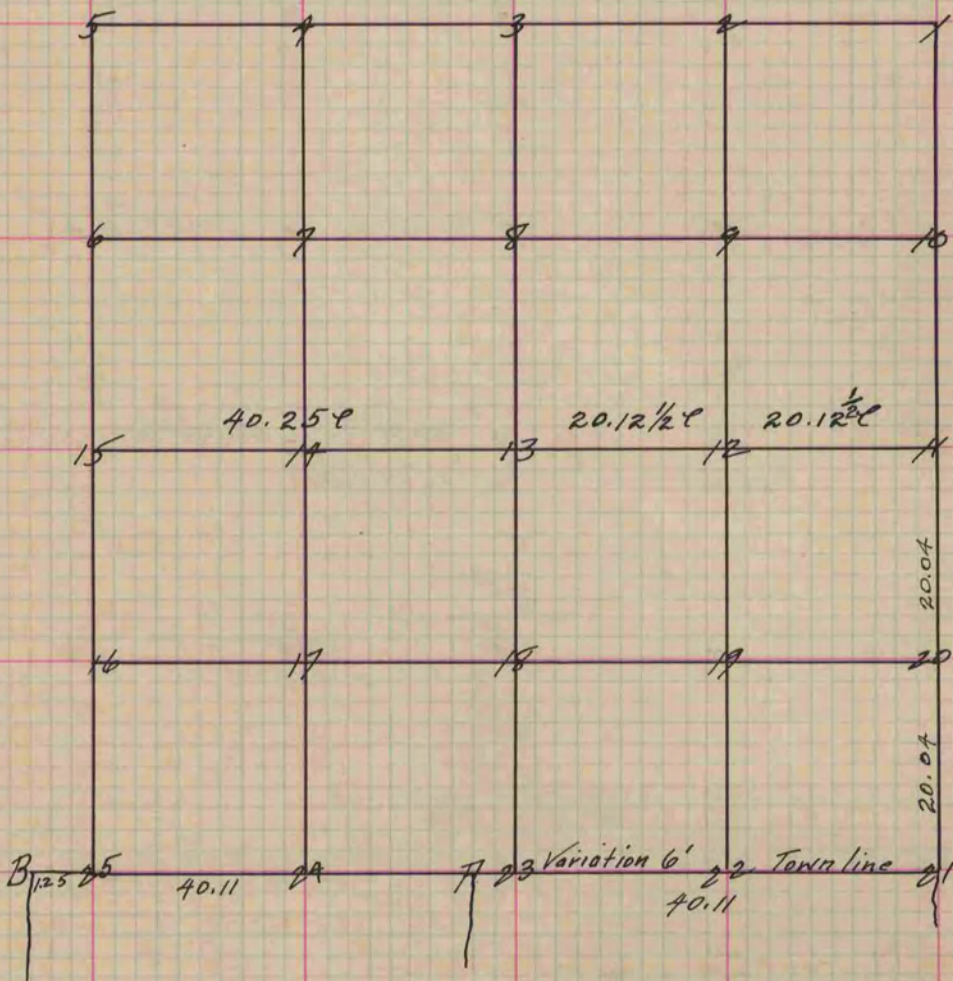


Fig. 13 Stake marked on the Prairie. No bearings.  
 " 18 " " " " " " " " "  
 " 21 " " in the Centre of Highway  
 Letter A on the South Line in the Centre between letter B & Fig. 21  
 one stake Marked no bearings.

Copied from Page 81 Vol. 1, Original County Surveyor's Record.