

PLAT AND RECORD

Of a Survey on Section 29 T 3 R 10 E. of the 4 P. M. in Magnolia Township


Rock County, Wisconsin, made March the 22nd & 23rd 1850

I hereby certify that the following is a correct record of said survey as made by me.

COUNTY BUILDING
IN CITY OF БЕЛОIT

(Signed) Joseph Church
RMB

County Surveyor.

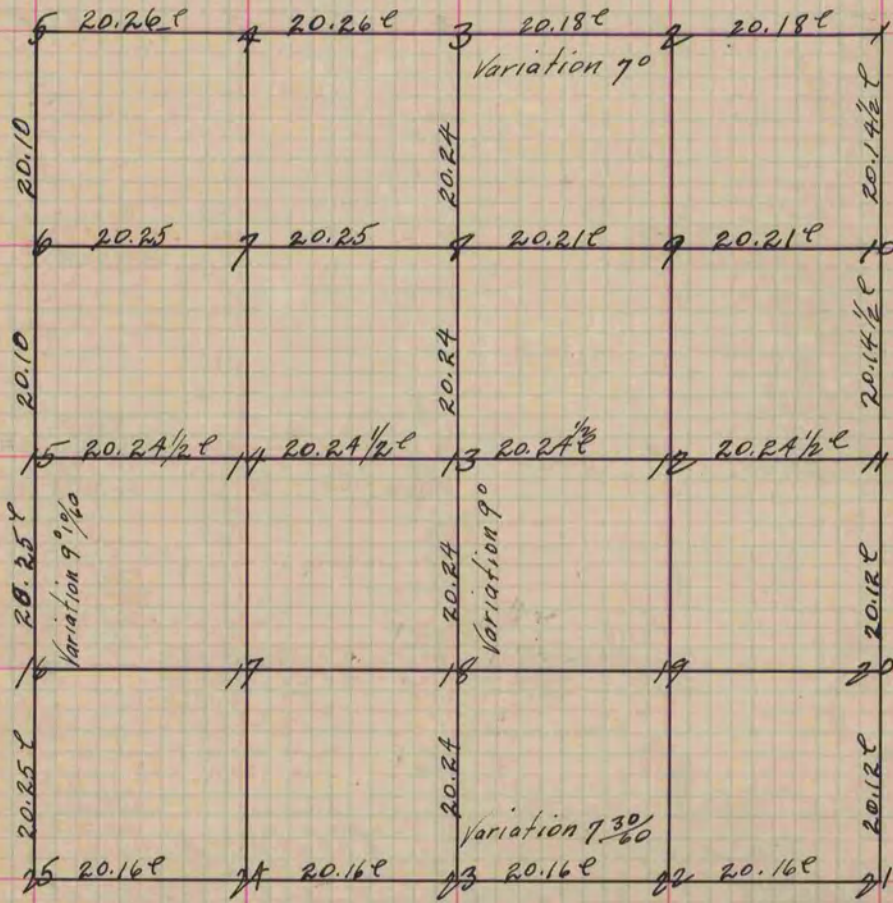

- Fig. 13 W. 0.36 N. 13 W. 39 Variation 9°
- " 7 Br. 0.12 N. 68 1/2 E. 35 links.
- " " 4 S. 4 W. 13 ℓ
- " 6 " " 2 S. 32 1/2 E. 68
- " " 14 N. 70 E. 170 Variation 9°
- " 4 W. 0.36 S. 24 1/2 E. 92
- " 20 Br. 0.14 N. 22 1/2 W. 32 ℓ Variation 9°
- " 25 Field notes incorrect
- " " Br. 0.16 N. 7 1/2 W. 166 1/2 links.
- " 2 " " 20 S. 39 W. 155
- " 12 " " 20 N. 54 1/2 E. 47
- " " 20 S. 47 W. No distance. Neglected to put it down.
- " 22 " " 16 N. 33 1/2 W. 93
- " 23 Field notes too short by 32 links.

Copied from Page 19 Vol. 1. Original County Surveyors Record.