


PLAT AND RECORD

Of a Survey on Section 6 T 2 R 10 E. of the 4 P. M. in Spring Valley Township
 Rock County, Wisconsin, made May the 11th 1855

I hereby certify that the following is a correct record of said survey as made by me.

COUNTY BUILDING
 IN CITY OF BELOIT

(Signed) Joseph Church
R.H.B. County Surveyor.

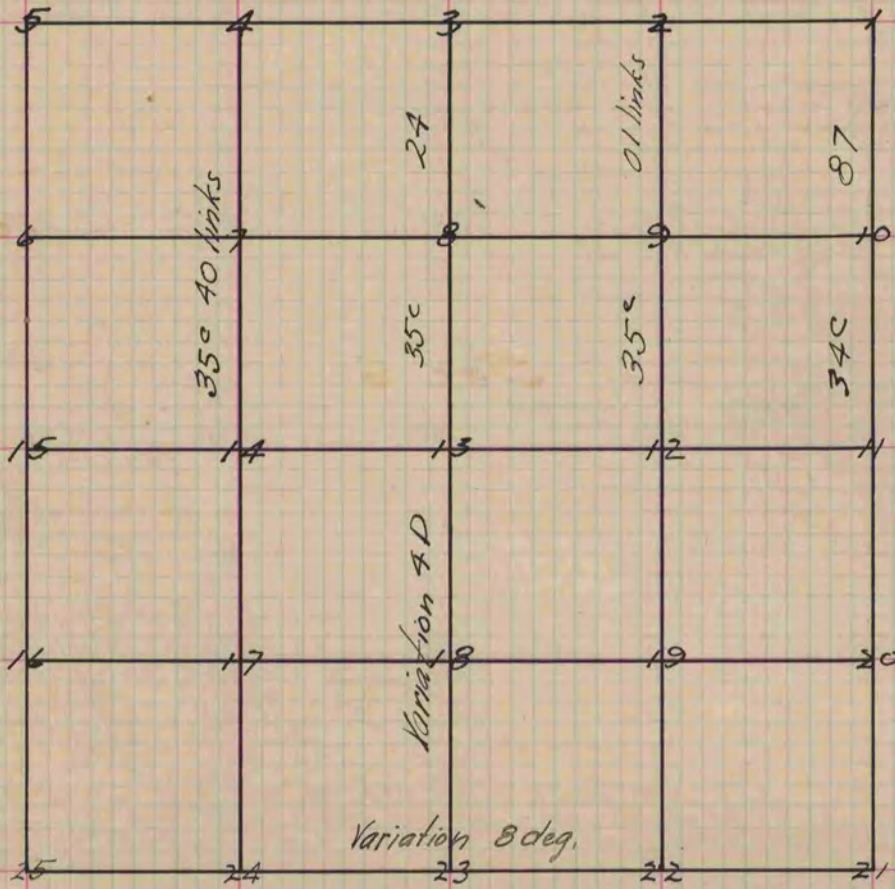

- Fig 13 Bur. O. S. 11 E. 85 links
 " " " " N 49 W. 109 "
 " 12 Black O. S. 86 E 203 "
 Bur. O. N 53 E 156 "
 " 14 " " N 58 E 47 "
 " " S. 65 W. 21 " the above notes were taken with Variation
 of 40. on the Compass
 " 3 Bur. O. S. 28 E 191 links
 " " S. 15 W. 195 "
 " 2 " " S. 9 E 225 "
 " " S. 45 W. 248 " the last were taken with 7/2

Copied from P. 37 Vol. 1. County Surveyors Record