

# PLAT AND RECORD

Of a Survey on Section 21 T 1 R 12 E. of the 4 P. M. in Beloit Township  
 Rock County, Wisconsin, made \_\_\_\_\_ the \_\_\_\_\_ 19\_\_\_\_


I hereby certify that the following is a correct record of said survey as made by me.

COUNTY BUILDING  
 IN CITY OF БЕЛОИТ

(Signed) *Edward Ruger*  
*E. R. A. B.*

County Surveyor.

*For Dexter, Farr & Dresser*  
*Distances given in Chains*  
*Variations marked on the lines.*

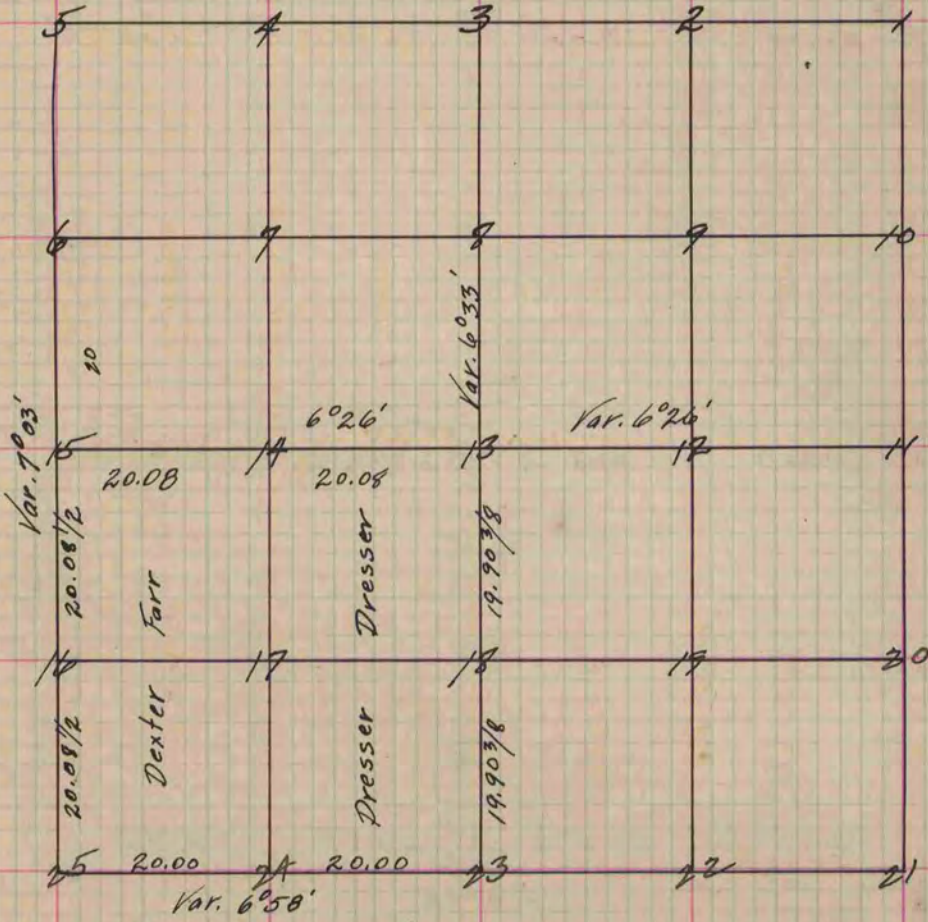

- At Fig. 3 Surrounded 1/4 Post by 4 hard head stones.
- " " 11 " " " " " " " " " "
- " " 13 " " " " " " " " " "
- " " 14 " " " " " " " " " "
- " " 15 " " " " " " " " " "
- " " 16 " " " " " " " " " "
- " " " Burr Oak 2 S. 7°03' W. 54 1/2
- " " " " 8 N. 2°18' W. 144 2/3 Var. 7°03'
- " " 17 Surrounded 1/4 Post by 3 hard head stones.
- " " 18 " " " " " " " " " "
- " " 23 " " " " " " " " " "
- " " 24 " " " " " " " " " "
- " " 25 " " Sec. Cor " " " Limestones " "
- " " " Took new Wit. trees
- " " " Burr Oak 10 S. 35°50' E. 196
- " " " Black Oak 5 S. 50°43' N. 155 1/3
- " " " Hickory 2 N. 64°31' W. 171 1/3 Var. 6°50'

Copied from page 105 Vol. 1. Original County Surveyor's Record.