

# PLAT AND RECORD

Of a Survey on Section 24 T 3 R 13 E. of the 4 P. M. in HARMONY Township

Rock County, Wisconsin, made January the 22 & 24 1859


I hereby certify that the following is a correct record of said survey as made by me.

(Signed) Edward Ruger  
RMR

County Surveyor.

COUNTY BUILDING  
IN CITY OF BELOIT

For John Turner

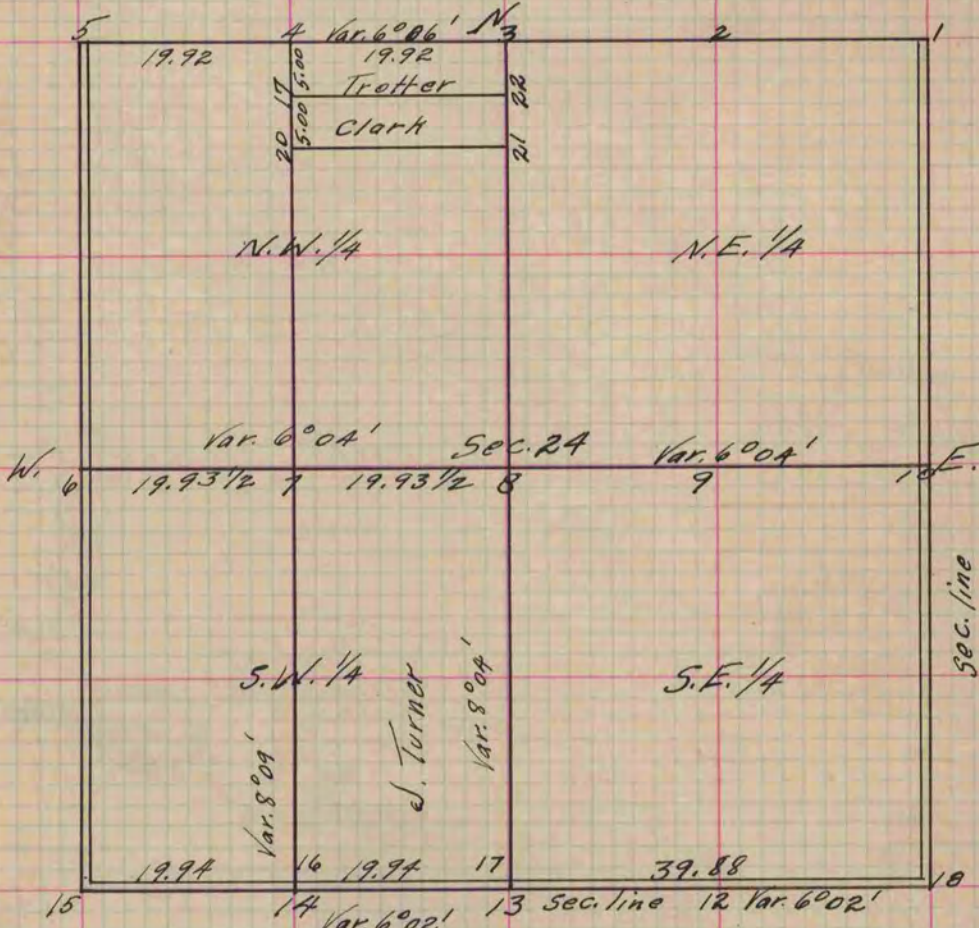

- " 4 Burr Oak stump 7 1/2 feet high 14 S. 81° 15' E. 55 1/2 links. var. 6° 05'
  - " 5 White " 3 " 6 S. 22° 30' E. 30. " var. 6° 05'
  - " 7 White Oak 26 N. 24° 15' E. 43  
" 24 N. 27° 30' W. 43 var. 8° 09'
  - " 8 White Oak 30 S. 80° E. 12 var. 8° 06'
  - " 8 " 30 S. 55° 30' W. 32 1/2
  - " 15 Locust 6 N. 32° 10' W. 102
  - " 7 N. 54° 30' W. 96 var. 6° 04'
  - " 16 Locust 7 N. 26° W. 19
  - " 7 N. 54° W. 28 1/2 var. 8° 09'
  - " 17 Locust 7 S. 64° 30' W. 6 1/2 var. 8° 06'
  - " 2 S. 80° 15' E. 11 1/2
  - " 18 Southwest Corner of Blacksmith Shop.  
N. 64° 35' E. 18 3/4
  - " Guide Board Post N. 83° 35' W. 37 1/2 var. 6° 04'
  - " 19 Burr Oak 12 S. 39° 10' E. 37 6° 06'
  - " 20 " 13 S. 20° 35' E. 19 6° 06'
  - " 21 White Oak 30 S. 85° E. 56 1/2 var. 8° 06'
  - " 22 Burr " 12 S. 73° 30' E. 25 1/2
- W. Old witness trees gone took new ones  
White Oak 30 S. 29° 05' W. 128°  
" " 20 N. 44° 15' E. 166 var. 7° 05'
- E. took new witness tree  
Burr Oak N. 68° 50' W.  
var. 6° 04'

Copied from Page 87 Vol. one Original County Surveyors Record.