

# PLAT AND RECORD

67


Of a Survey on Section 18 T 2 R 11 E. of the 4 P. M. in Plymouth Township  
 Rock County, Wisconsin, made March the 19<sup>th</sup> 1857

I hereby certify that the following is a correct record of said survey as made by me.

COUNTY BUILDING  
 IN CITY OF BELOIT

(Signed) Joseph Church  
JAC

County Surveyor.

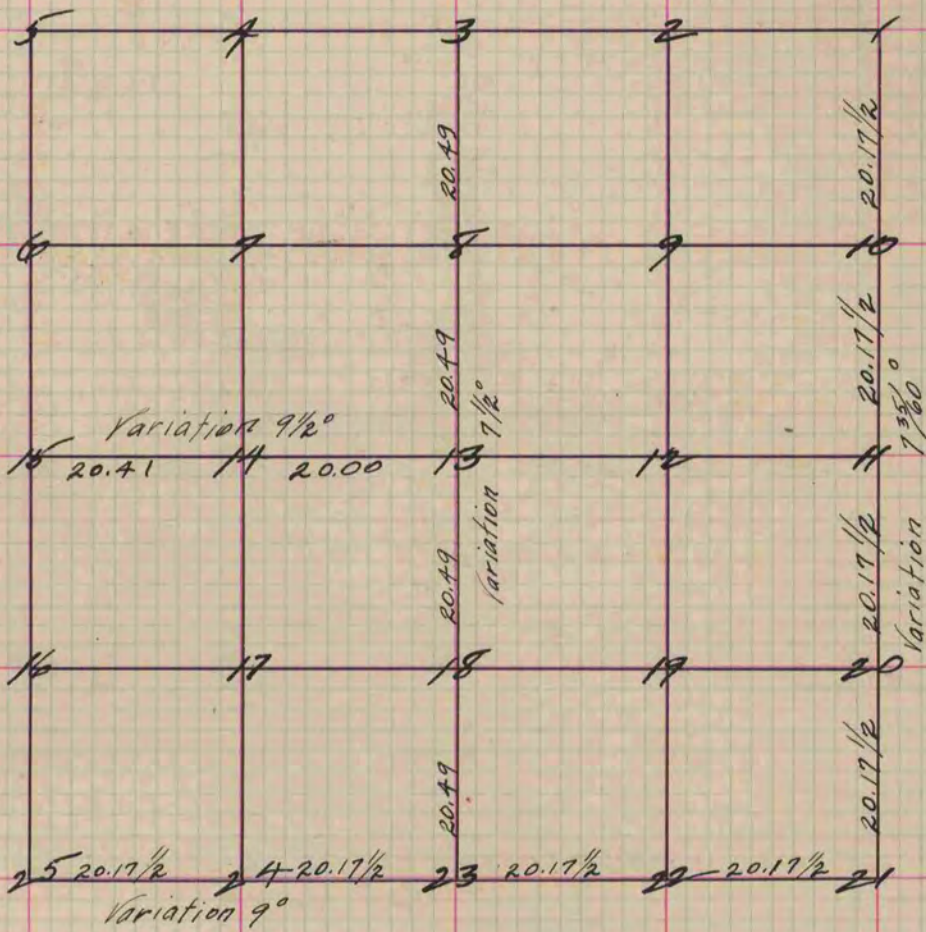

- Fig. 13 Stake and Stone in Marsh.
- " 8 " " " " "
- " 3 " " " " "
- " 2 " " " " "

- " 19 Stake no bearings.
- " 18 Br. O. 8 S. 4 1/2 W. 139  
 Red O. 12 N. 1 W. 311

Wit. to corner 91 links on the line West of Fig. 14.  
 Br. O. 105. 30 1/2 E. 28  
 Bl. O. 14 N. 74 1/2 E. 49

Fig. 17 Br. O. 13 N. 58 1/4 E. 130  
 W. O. 14 N. 6 W. 109 V. 7 1/2 Degrees.

Copied from Page 68 Vol. 1 Original County Surveyors Record