


# PLAT AND RECORD

Of a Survey on Section 26 T 4 R 10 E. of the 4 P. M. in Union Township  
Rock County, Wisconsin, made March the 21<sup>st</sup> 1856

I hereby certify that the following is a correct record of said survey as made by me.

COUNTY BUILDING  
IN CITY OF БЕЛОIT

(Signed) Joseph Church  
JAC County Surveyor

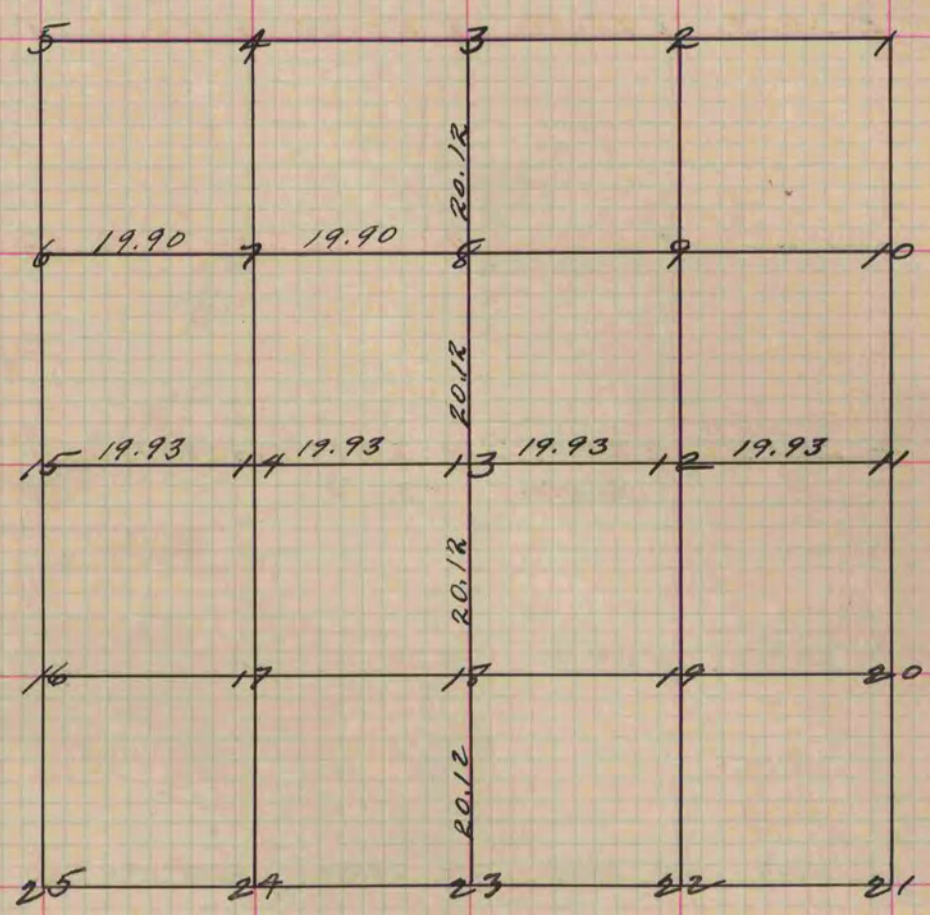

- Fig. 13 Br. O. 20 N. 89 E. 218
- " " 30 S. 85 E. 312 1/2
- 12 " 20 N. 65 3/4 E. 131
- " 20 S. 80 1/2 E. 121
- 7 " 24 N. 76 3/4 E. 347
- " 30 N. 12 1/4 E. 401 1/2
- 14 " Stake in Centre of Road, no bearings.

Copied from Page 64 Vol. 1 Original County Surveyors Record