U.S.


PUBLIC LAND SURVEY MONUMENT RECORD

For Public Land Survey Corners In:

WI ADMINISTRATIVE CODE A-E 7.08 REQUIREMENT

T. 2 N. R. \_//\_E.

CORNER CODE INDEX

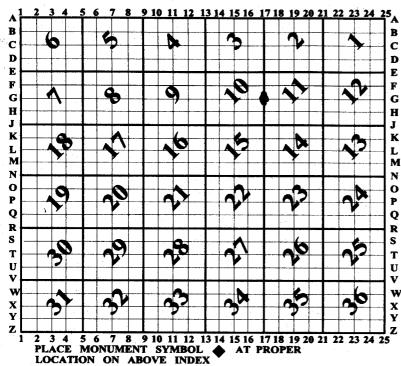

PLYMOUTH TWP ROCK COUNTY WI

IF AVAILABLE
ROCK COUNTY COORDINATES PERFERRED

North	Elev.
East	
Hor. Datum _	Vert. Datum
LATITUDE	ELLIPS. HT
LONGITUDE	
GPS (X)	TRAVERSE (X)
BASED ON TH	HE FOLLOWING CONTROL:

**♦ CORNER MONUMENT** 

WITNESS MONUMENT

BEARINGS ARE BASED ON:

**(a)** 

OBSEKYATION Sheet #12/

FIELD BOOK \_\_\_\_\_ PAGE # \_\_\_\_\_ SHEET \_\_\_\_ SHOW A PLAN VIEW DRAWING DEPICTING THE CORNER MONUMENT AND SURROUNDING PHYSICAL FEATURES, INCLUDING THE EXCAVATION AREA AND DEPTH.
PLANNING & ZONING COMMITTEE ADOPTED THE ABOVE FORM ON 12/2/1982

PL538

(B) Describe any record evidence, monument evidence, occupational evidence, testimonial evidence or any other material evidence you considered, and whether the monument was found or placed.

1833 HARRISON

NORTH BET SEC 10 & 11

2640 5280 QUARTER SEC COR. POST & RAISED MOUND COR. TO SECS 2, 3, 10, 11 NEAR THE SOUTHERN EDGE OF DRY PRAIRIE SET POST & RAISED MOUND

LAND LEVEL 2ND RATE DEC 22

1855 CHURCH VOL 1 PG 34 COTTONWOOD 2 674 ½ W 77.22'. 2640 TO CENTER SEC 11 & 5220.6 TO E ¼ COR SEC 11

1855 CHURCH VOL 1 PG 40 2630.76 TO CENTER SEC 10 & 5261.52 TO W 1/4 COR SEC 10

1865 LOCKE VOL 1 PG 240 FENCE RIGHT. 2600.53 TO CENTER SEC 11 & 5201.92 TO E 1/4 COR SEC 11

1868 LOCKE

PG 43 SOUTH BETWEEN SECS 10 & 11 VAR 6-15

2640 SET TEMPORARY 1/4 COR COR LOST.

5300.46 INTERSECTED SOUTH BOUNDARY AT COR. COR. SET AS PREVIOUSLY GIVEN ON PAGE 39.

2650.23 SET 1/4 COR 10.23' NORTH OF TEMPORARY 1/4 COR.

1452 CENTER OF RR TRACK

AUG 29 1868

1869 LEE VOL 2 PG 1 FD MON VAR 6-40 ALONG E/W CENTERLINE SEC 11.

1871 RUGER VOL 2 PG 60 STONE MON. VAR 4-57 2634.72 TO CENTER SEC 10.

1871 RUGER VOL 2 PG 67 STONE MON.

1988 BARNES VOL 6 PG 389 REC MEASUREMENTS.

FD LARGE PIECES OF CUT L.S. ABOUT 12" - 15" DEEP. DID NOT FIND BOTTOM. SET POLY. MON. WITH 2 MAGNETS AT BASE & 2 MAGNETS ABOUT 15" ABOVE BASE. LAID PIECES OF L.S. AROUND POLY & PLACED CARSONITE POST ON NW SIDE OF MON.

C) Was the corner restored through acceptance of (1) an obliterated evidence location, or, (2) a found perpetuated location?

ACCEPTED FD PIECES OF OUT LIMESTONE, WHICH ARE IN HARMONY WITH LOCKE'S MEASUREMENTS.

- D) Describe any material discrepancy between the location of the corner as restored or reestablished and the location of that corner as previously restored or reestablished by distance and direction. Show the discrepancy on the plan view drawing under (a), above. Show the distances between the corner as previously restored or reestablished and (1) the corner as restored or reestablished, and (2) to at least 4 of the witness monuments shown on the drawing in (a), above.
- (E) Was the corner reestablished through lost corner proportionate methods? If so, show the method, including the directions and distances to other public land survey corners used as evidence or used for proportioning the corner location.
- I, Donald Barnes, hereby certify that the corner location as identified by the corner code index was determined by me under my direction and control and that this U.S. Public Land Survey Monument Record is correct and complete to the best of my knowledge and belief.

Sent

Possid Barnes

SHEET 1 OF 2

12-27-02

CORNER CODE G-17

A-E 7.08 REQUIREMENT

