

U.S. PUBLIC LAND SURVEY MONUMENT RECORD

For Public Land Survey Corners in:

WI ADMINISTRATIVE CODE A-E 7.08 REQUIREMENT

T. 2 N., R. 11 E

CORNER CODE INDEX

A	1	2	3	4	5	6	7	8	9	10	11	12	13	14	15	16	17	18	19	20	21	22	23	24	25
B																									
C	6																								
D																									
E																									
F																									
G	1																								
H																									
I																									
J																									
K	18	17																							
L																									
M																									
N																									
O																									
P	19	20	21	22	23	24																			
Q																									
R																									
S	30	29	28	27	26	25																			
T																									
U																									
V																									
W																									
X	31	32	33	34	35	36																			
Y																									
Z																									

PLYMOUTH TWP
ROCK COUNTY WI

IF AVAILABLE
ROCK COUNTY COORDINATES PREFERRED

North _____ Elev. _____

East _____

Hor. Datum _____ Vert. Datum _____

LATITUDE _____ ELLIPS. HT. _____

LONGITUDE _____

GPS (X) _____ TRAVERSE (X) _____

BASED ON THE FOLLOWING CONTROL:

PLACE MONUMENT SYMBOL AT PROPER LOCATION ON ABOVE INDEX

CORNER MONUMENT

WITNESS MONUMENT

(a)

BEARINGS ARE BASED ON:

OBSERVATION SHEET 137 & 245

FIELD BOOK _____ PAGE # _____

SHEET 1 OF 34

SHOW A PLAN VIEW DRAWING DEPICTING THE CORNER MONUMENT AND SURROUNDING PHYSICAL FEATURES, INCLUDING THE EXCAVATION AREA AND DEPTH.

PLANNING & ZONING COMMITTEE ADOPTED THE ABOVE FORM ON 12/2/1982

CORNER CODE N-17

PL569

(B) Describe any record evidence, monument evidence, occupational evidence, testimonial evidence or any other material evidence you considered, and whether the monument was found or placed.

- 1833 HARRISON EAST BETWEEN SECS 14 & 23
2640 TEMPY 1/4 SEC COR
3432 LEFT TIMBER & ENTER MARSH
5293.86 INT. E BDY 9.9' S OF P LAND ROLLING 2ND RATE TIM
BURR & BLK O GRASS & WEEDS
COR WEST
2646.93 QUARTER SEC COR {BLK O 24 S24W 15.18' BLK 10
S44E 18.48' BLK O 24 BLK O 10} MARKED
5293.86 SEC COR
NORTH BET. 22 & 23
2278.98 W.O. 18
2640 QUARTER SEC COR. {W.O. 24 N75W 33' BLK O 10
S25E 32.34' W.O. 24 BLK O 10} MARKED
3666.96 W.O. 18
5280 COR TO SECS 14 15 22 23 {BURR O 18 S29E
70.62' BURR O 14 S4W 79.2' BURR O 6 N79W
91.74' BLK O 11 N73E 186.78' LAND ROLLING 2ND
RATE WITH TIMBER & BURR O BLK O. HICKY, W.O.
BUSHES, GRASS & WEEDS
{1856 CHURCH VOL 1 PG 64 WITNESS TREES
INCORRECT. FOUND
STAKE FROM TREE MARKED BEARING S47W 180
LINKS (118.8') & A TREE BEARING S29E 187
(123.42'). GOVERNMENT FIELD NOTES CALLS FOR
THE STAKE FOR ONE TREE S29E 107 LINKS (70.62')
THE OTHER S4W 120 LINKS (79.2')}
NORTH BET 14 & 15
2640 QUARTER SEC COR {BURR O 14 S43E 18.48' BURR
O 24 S70W 52.8' BURR O 14 BURR O 24} MARKED
2665.08 BURR O 14
3402.96 BURR O 24
4488 LEFT TIMBER & ENTER MARSH
4917 BROOK 33' S.E.
5280 COR TO SEC 10, 11 14 15 POST & MOUND OF
TAMRACKS LAND ROLLING ON S 1/4 AS BEFORE &
NORTH 1/2 LEVEL & WET 3RD RATE
EAST ON RANDOM BET 15 & 22
1122 LEFT TIMBER & ENTER MARSH
1650 LEFT MARSH
2640 TEMPY 1/4 P
5240.4 INT. E BDY 17.82' N OF P LAND LEVEL & SOMEWHAT
WET 2ND RATE WITH TIMBER OF BURR O & WHITE O
COR W
2620.2 QUARTER SEC COR {BURR O 24 N13W 82.5' BURR
O 18 S7E 44.22' BURR O 24 BURR O 18} MARKED
4730.88 BURR O 12
1848 TWP RD REC BK 1 PG 23 & 24 BEGINNING AT THE 1/4 POST
ON THE NORTH LINE OF SEC OF 11 OF T2, R11E OF THE 4TH
P.M. AND RUNNING THENCE SOUTH 3960' ON THE LINE
THROUGH THE CENTER OF SEC; THENCE RUNNING S17-30W
1996.5' TO THE CENTER OF NEW BRIDGE OVER BASS CREEK
AND RUNNING THENCE S32-30W 1122' TO THE RD THROUGH
THE CENTER OF THE W 1/2 OF SEC 14, SAME TWP AND RANGE.
MAGNETIC VARIATION 6-30 EAST; THENCE SOUTH ON THE HALF
QUARTER LINE TO THE SOUTH LINE OF SEC 14; THENCE WEST
1320' ON THE SEC LINE TO THE NW COR OF SEC 23; THENCE
SOUTH ON THE SEC LINE BETWEEN COR OF SEC 23; THENCE
SOUTH ON THE SOUTH LINE BETWEEN SECS 22 & 23 AND 26
AND 27, 34, & 35 TO THE SOUTH LINE OF THE TOWN. SAID RD
IS 66' IN WIDTH.
1855 CHURCH VOL 1 PG 35 BUR OAK 20 S19E 95.7', BUR OAK 20
S52W 125.40'. THE TREES AS MINUTED ON THE GOVERNMENT
SURVEY IS IN ERROR TO MY SATISFACTION. THE ABOVE

SHEET 1 OF 4 CORNER CODE N-17

Donald Bunes

3-07-03

PL569

SURVEY IS INCORRECT CAUSED BY GOVERNMENT FIELD NOTES NOT BEING CORRECT. REFER TO PAGE 65 (SIGNED JOSEPH CHURCH COUNTY SURVEYOR)

1856 CHURCH VOL 1 PG 64 WITNESS TREES INCORRECT. FOUND STAKE FROM TREE MARKED BEARING S47W 180 LINKS (118.8') & A TREE BEARING S29E 187 (123.42'). GOVERNMENT FIELD NOTES CALLS FOR THE STAKE FOR ONE TREE S29E 107 LINKS (70.62') THE OTHER S4W 120 LINKS (79.2')

1868 LOCKE

PG 22 EAST BETWEEN SECS 15 & 22 VAR 6-37

1298.88 CENTER SMALL BRIDGE
2636.37 INTERSECTED ¼ LINE 23.76' NORTH OF COR. FOUND STUMPS OF BTS AND WHERE STAKE WAS EVIDENTLY PULLED OUT. SOUTH BT IS S70E COR IN CENTER OF HIGHWAY VAR CORRECTED 6-06

CONTINUED EAST FROM ¼ COR WITH VAR 5-45

5269.11 INTERSECTED EAST BOUNDARY AT COR. FOUND BT IN SEC 22 & STUMPS OF BTS IN 14 15 23 AND STAKE BT IN 22 IS S47W 112.2' & DIST TO BT IN 23 IS 103.62' COR IN CENTER OF HIGHWAY AND IN LINE OF FENCE RUNNING NORTH VAR CORRECTED 5-45 AUG 22 1868

PG 23 NORTH BETWEEN SECS 22 & 23 VAR 7-12

2364.12 W O. LINE TREE
2650.56 INTERSECTED ¼ LINE 6.6' WEST OF COR. FOUND WEST BT AND OLD STAKE VAR CORRECTED 7-04

SET OFF 15.18' EAST FROM ¼ COR AND AND CONTINUED NORTH WITH VAR 7-28

5305.08 INTERSECTED NORTH BOUNDARY 5.94' WEST OF COR. VAR CORRECTED 7 AUG 24, 1868

PG 24 EAST BETWEEN SECS 14 & 23 VAR 6-40

1980 SET OFF 15.18' SOUTH
2659.8 INTERSECTED ¼ LINE 2.97' SOUTH OF COR. FOUND STUMPS OF BTS AND OLD STAKE VAR CORRECTED 6-16 COR 4 FT N AND 1 FT WEST OF COR OF BOARD FENCES RUNNING N & E

CONTINUED EAST FROM ¼ COR WITH VAR 6-15

5317.62 INTERSECTED EAST BOUNDARY 1.32' NORTH OF COR. FOUND EAST BT AND STUMP OF WEST BT AND STAKE. 1070.85' TO EAST B.T. AND 1075.8' TO WEST BT COR IN FENCE (N&S) VAR CORRECTED 6-14 DROVE STAKES AT SIDES OF MONUMENT AND MADE A MOUND OF TUSSECKS AROUND. AUG 24 1868

PG 41 NORTH BETWEEN SECS 14 & 15 VAR 7-25

2661.78 INTERSECTED ¼ LINE 7.92' WEST OF COR. FOUND STUMPS OF B.T.S AND STAKE. VAR CORRECTED 7-15

SET OFF 29.7' WEST OF ¼ COR. AND CONTINUED NORTH WITH VAR 6-15

2686.86 LINE TREE. DUG OUT.

4719 CENTER OF M&M RR

5312.01 INTERSECTED NORTH BOUNDARY AT COR. SET AS PREVIOUSLY GIVEN. (PAGE 39) VAR CORRECTED 6-54 AUGUST 29 1868

1870 RUGER VOL 2 PG 47 FD STONE MON SET BY LOCKE VAR 6-39 2654.85 TO S ¼ COR SEC 14 & VAR 6-56 2649.90 TO W ¼ COR SEC 23.

1873 RUGER VOL 2 PG 112 FD STONE MON. VAR 6-50 2628.12 TO S ¼ COR SEC 15.

1874 RUGER VOL 2 PG 137 FD STONE MON. VAR 6-50 2628.12 TO S ¼ COR SEC 15 & VAR 7-10 TO E ¼ COR SEC 15

1961 BATTERMAN VOL 4 PG 121 FOUND BROKEN PART OF MONUMENT IN DITCH AND DUG 20X20X4 HOLE LOOKING FOR REMAINS OF MONUMENT BUT COULDN'T FIND ANY SO RESET

Donald Barnes
3-07-03

PL569

CORNER BY DOUBLE PROPORTIONATE MEASUREMENT.
SHOWS THE FOLLOWING DISTANCES:

2660.94 TO S 1/4 COR SEC 23
2676.12 TO S 1/4 COR SEC 24
2659.99 TO E 1/4 COR SEC 26

1980 TALARYCZK CSM VOL 10 PG 3 FD ALUM.

1980 BARNES VOL 6 PG 40 FD CUT LIMESTONE 36" DEEP. SET
ALUM MON ON TOP OF STONE. FD 2" PIPE 15" DEEP N67-33-
42E 2.67' OF THE LIMESTONE. THE FOLLOWING BEARINGS &
DISTANCES ARE FROM THE SE COR SEC 15:

N88-35-40W 2632.72 TO S 1/4 COR SEC 15
S89-31-57E 1333.14 TO HH @ S 1/16TH COR OF SW 1/4 SEC
14 S0-09-34W 2654.11 TO E 1/4 COR SEC 22
N0-09-45E 2660.26 TO E 1/4 COR SEC 15
N67-33-42E 2.67 TO FD 2" PIPE 15" DEEP

1981 TALARYCZK CSM VOL 10 PG 284 FD ALUM.

1982 BARNES VOL 6 PG 282 RECORD DISTANCES. N0-43-18W
2660.26 TO E 1/4 COR SEC 15, N89-35-10E 1333.14 TO
S 1/16TH COR OF SW 1/4 SEC 14, & N89-38-24E 1332.51 FROM
S 1/16TH COR OF SW 1/4 SEC 14 TO S 1/4 COR SEC 14

1982 THOM CSM VOL 11 PG 343 FD COUNTY SURVEYOR MON.
2666.24 TO S 1/4 COR SEC 14

1983 BARNES N-19 N89-35-10E 1333.49 TO S 1/16TH COR OF SW
1/4 COR SEC 14 & N89-38-24E 1332.51 FROM S 1/16TH COR
OF SW 1/4 SEC 14 TO S 1/4 COR SEC 14

1983 THOM CSM 11-343 FD COUNTY MON. 2666.24 TO S 1/4 COR
SEC 14 (LOST BY MINING - COMPUTED).

1987 COMBS CSM VOL 12 PG 559 FD ALUM. EAST 1333.14 TO
1/16TH COR

1989 COMBS MAP #12236 FD ALUM. MON. MORTGAGE
INSPECTION.

1992 SCHROEDER MAP #11327 MORTGAGE INSPECTION. STATES
NOTHING ABOUT MON.

1999 COMBS CSM VOL 22 PG 282 & VOL 12 PG 559 FD ALUM
2660.0 TO W 1/4 COR SEC 14 & EAST 1333.13 TO STONE AT
1/16TH COR

1999 COMBS CSM VOL 22 PG 459 FD ALUM 2660.0 TO ALUM @
W 1/4 COR SEC 14

FD ALUM. MON.

C) Was the corner restored through acceptance of (1) an obliterated evidence location, or, (2) a found perpetuated location?

ACCEPTED ALUM. MON., WHICH IS ON TOP OF CUT L.S.

D) Describe any material discrepancy between the location of the corner as restored or reestablished and the location of that corner as previously restored or reestablished by distance and direction. Show the discrepancy on the plan view drawing under (a), above. Show the distances between the corner as previously restored or reestablished and (1) the corner as restored or reestablished, and (2) to at least 4 of the witness monuments shown on the drawing in (a), above.

PIPE IN MON. BOX IS N67-01-03E (COUNTY PROJECTION) 2.68'
FROM ALUM. MON (CUT L.S.)

I, Donald Barnes, hereby certify that the corner location as identified by the corner code index was determined by me under my direction and control and that this U.S. Public Land Survey Monument Record is correct and complete to the best of my knowledge and belief.

Donald Barnes

Seal
Emboss


3-07-03

SHEET 3 OF 4

CORNER CODE N-17

A-E 7.08 REQUIREMENT

W 1/4 CDR
SEC 14

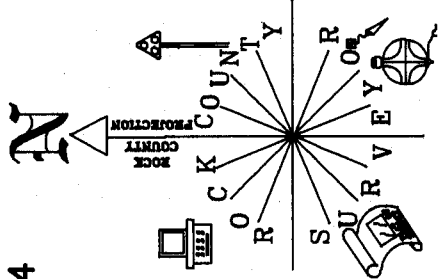

NOT TO SCALE

N00-41-08W 2660.20 L.S.(ALUM)
N0-44-19W 2659.18 IP

1330.69 IP 1/16TH

N89-39-55E IP CDR

N89-37-15E L.S.(ALUM)
1333.15 L.S.(ALUM)

N00-38-06W 2655.15 IP

N00-41-17W 2654.12 L.S.

2" PIPE
15" DEEP



N66-42-40E
2.67

NE CDR
SEC 22
ALUM.
L.S. 36"
DEEP

S89-27-52E 2635.23 IP

S89-26-28E 2632.79 L.S.(ALUM)

S 1/4 CDR
SEC 15

NE CDR SEC 22
PLYMOUTH TWP

OBSERVATION SHEETS 118 & 802

EMBOSSED SEAL

Donald Barnes
May 12 2003

SHEET 4 OF 4

N-17

E 1/4 CDR
SEC 22

217