
U.S.

PUBLIC LAND SURVEY MONUMENT RECORD

For Public Land Survey Corners in: WI ADMINISTRATIVE
T. ZN., R. // E

WI ADMINISTRATIVE CODE A-E 7.08 REQUIREMENT

CORNER CODE INDEX

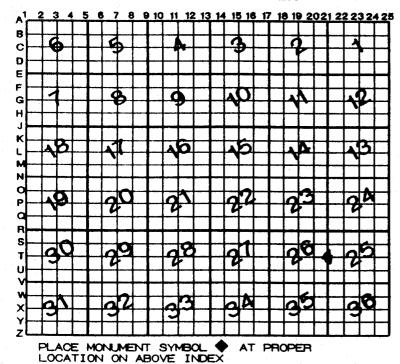

PLYMAUTH TWP ROCK COUNTY WI

IF AVAILABLE ROCK COUNTY COORDINATES PERFERRED

North _____ Elev. _____ Elev. ____ East ____ Vert. Datum ____ ELLIPS. HT.

GPS (X) ___ TRAVERSE (X) ___

BASED ON THE FOLLOWING CONTROL:

♦CORNER MONUMENT

O WITNESS MONUMENT

LONGITUTE

BEARINGS ARE BASED ON:

(a)

FIELD BOOK	PAGE #	SHEET	of <u>3</u>
SHOW A PLAN VIEW	DRAWING DEPICTING T	NT AND SURROUNDING	
	INCLUDING THE EXCAN	EPTH.	

PL599

(B) Describe any record evidence, monument evidence, occupational evidence, testimonial evidence or any other material evidence you considered, and whether the monument was found or placed.

1833 HARRISON NORTH BETWEEN 25 & 26 (VAR8-DDE)

324.72 RED DAK 24 IN DIAM

657.36 ELM 12 IN DIAM

1151.04 ASH 36 IN DIAM

CHERRY 24 IN DIA 1617

QUARTER SEC COR. (BUR DAK 14 S29E 129.36' 2640 ASPEN 6 N66W 63.36' BUR DAK D 14 ASPEN 6 **MARKED**

4290 LEFT TIMBER ENTER MARSH

5082 LEFT MARSH ENTER TIMBER

COR TO SECS 23,24,25,26 {BUR O B 573E 36.96' BUR O 9 N56E 53.46' BURR O 1 S56W 90.42' W O 5280 36 N19W 164.34' LAND HIGH R?? 1ST RATE TIMBER RED, W, & BURR O. ASPEN, ELM WALNUT.

1849 Mc VANE TOWN ROAD RECORDS BK 1 PG 26 """ THE WIDTH OF 9.5' AND SAID COMMISSIONERS HAVE CAUSED A SURVEY THERE OF TO BE MADE AS FOLLOWS; THE CENTER LINE OF SAID HWY IS TO COMMENCE AT THE NW COR OF SEC 25; THENCE RUNNING SOUTH ON THE SOUTH ON THE SECTION 26 TO THE SW COR OF SAID SEC 25; THENCE SOUTH ON THE SEC LINE BETWEEN SEC 35 AND SEC 36 TERMINATING ON THE SOUTH LINE OF SAID TOWN THE CENTER OF HWY TO BE ON THE SEC LINE.

1865 LOCKE VOL 1 PG 248 & MAP #04405 FD 9 O. & OLD STAKE ASPEN GONE. SET STAKE WITH HH 11X8X7 ON NORTH. VAR 6-30 2671.02 TO CENTER SEC 26 & VAR 7-35 2656.50 TO SE SEC 26.

1868 LOCKE

PG 6 NORTH BETWEEN SECS 25 & 26 VAR 7-15 INTERSECTED 1/4 LINE AT COR. FOUND COR AS SET 2666.07 BY SELF (SEE COUNTY SURVEYORS RECORD SEC 26) & BT IN SEC 25. CORNER IN CENTER OF HIGHWAY & IN LINE WITH FENCE RUNNING WEST CONTINUED NORTH FROM 1/4 COR WITH VAR 7

INTERSECTED NORTH BOUNDARY 16.5' EAST OF 5330.49 COR VAR CORRECTED 7-21 AUG 18 1868

1869 LEE VOL 1 PG 338 FD MON VAR 6-45 2665.74 TO NE COR SEC 26 & VAR 6-23 ALONG E/W CENTER LINE OF SEC 26

1873 RUGER VOL 2 PG 115 STONE MON. VAR 4-53 2651.22 TO CENTER SEC 25 & VAR 6-20 ALONG EAST LINE OF SE 1/4 SEC

1882 LEE VOL 2 PG 367 MON VAR 6- 2656.83 TO SE SEC 26.

1961 BATTERMAN VOL 4 PG 121 DUG 5X4X7 DEEP AT W 1/4 COR SEC 25 & FD CUT STONE MON. REF. SAME 2659.99 TO NE COR SEC 26

1962 THOM MAP #04393 FD CUT LIMESTONE 2651.04 TO CEN **SEC 25**

1976 LEE CSM VOL 5 PG 273 STATES NOTHING ABOUT MON 1981 BARNES R-21 2664.10 TO NE COR SEC 26 & 2660.00 TO ERRONEOUS MONUMENT BOX NEAR NE COR SEC 26. FD PK

ABOUT 0.2' DEEP FD PAINTED PK IN ROAD SURFACE. FD 1" PIPE IN HORIZONTAL POSITION ABOUT 1.4' BELOW RD SURFACE. FD 1" PIPE 3.8' BELOW RD SURFACE IN EXCELLENT CONDITION. FD REFERENCE PIPES. ACCEPTED FD PIPE AND PLACED ALUM. MON. OVER PIPE. ALSO PLACED MAGNETS AT THE BOTTOM OF THE MON. AND AT ABOUT THE HALF THE DISTANCE TO THE TOP OF THE MONUMENT.

SHEET 1 OF 3 CORNER CODE T-21

Dendel Barres May 9, 2003

PL599

C) Was the corner restored through acceptance of (1) an obliterated evidence location, or, (2) a found perpetuated location?

ACCEPTED 1" PIPE. THIS PIPE FITS THE OBSERVATIONS TO A PK THAT I FOUND IN 1982. THE FD 0.2' DEEP PK FITS THE TIES BETTER.

D) Describe any material discrepancy between the location of the corner as restored or reestablished and the location of that corner as previously restored or reestablished by distance and direction. Show the discrepancy on the plan view drawing under (a), above. Show the distances between the corner as previously restored or reestablished and (1) the corner as restored or reestablished, and (2) to at least 4 of the witness monuments shown on the drawing in (a), above.

THE DISCREPANCY FROM THE FO PK TO THE PIPE IS SHOWN IN THE SKETCH.

(E) Was the corner reestablished through lost corner proportionate methods? If so, show the method, including the directions and distances to other public land survey corners used as evidence or used for proportioning the corner location.

I, **Donald Barnes**, hereby certify that the corner location as identified by the corner code index was determined by me under my direction and control and that this U.S. Public Land Survey Monument Record is correct and complete to the best of my knowledge and belief.

and a

SHEET 2 OF 3

CORNER CODE **T-21**A-E 7.08 REQUIREMENT

