


U.S. PUBLIC LAND SURVEY MONUMENT RECORD

For Public Land Survey Corners in the
T. 2 N., R. 11 E

CORNER CODE INDEX

	2	3	4	5	6
A					
B	6	5	4	3	2
C					
D					
E					
F					
G	7	8	9	10	11
H					
I					
J					
K					
L	18	17	16	15	14
M					
N					
O					
P	19	20	21	22	23
Q					
R					
S					
T	30	29	28	27	26
U					
V					
W					
X	31	32	33	34	35
Y					
Z					

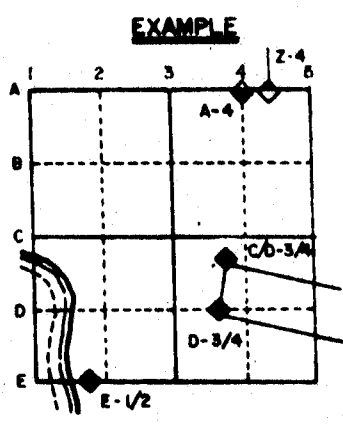

PLYMOUTH TWP
ROCK COUNTY WI


IF AVAILABLE
STATE PLANE COORDINATES

North (Y) _____ Eleve. (Z) _____
 East (X) _____ Zone _____
 Hor. Datum _____ Vert. Datum _____

PLACE MONUMENT SYMBOL (◆) AT PROPER LOCATION ON ABOVE INDEX

(a.)

◆ CORNER MONUMENT
ALUM. MON
○ WITNESS MONUMENT 1/2 X 24" RE ROD

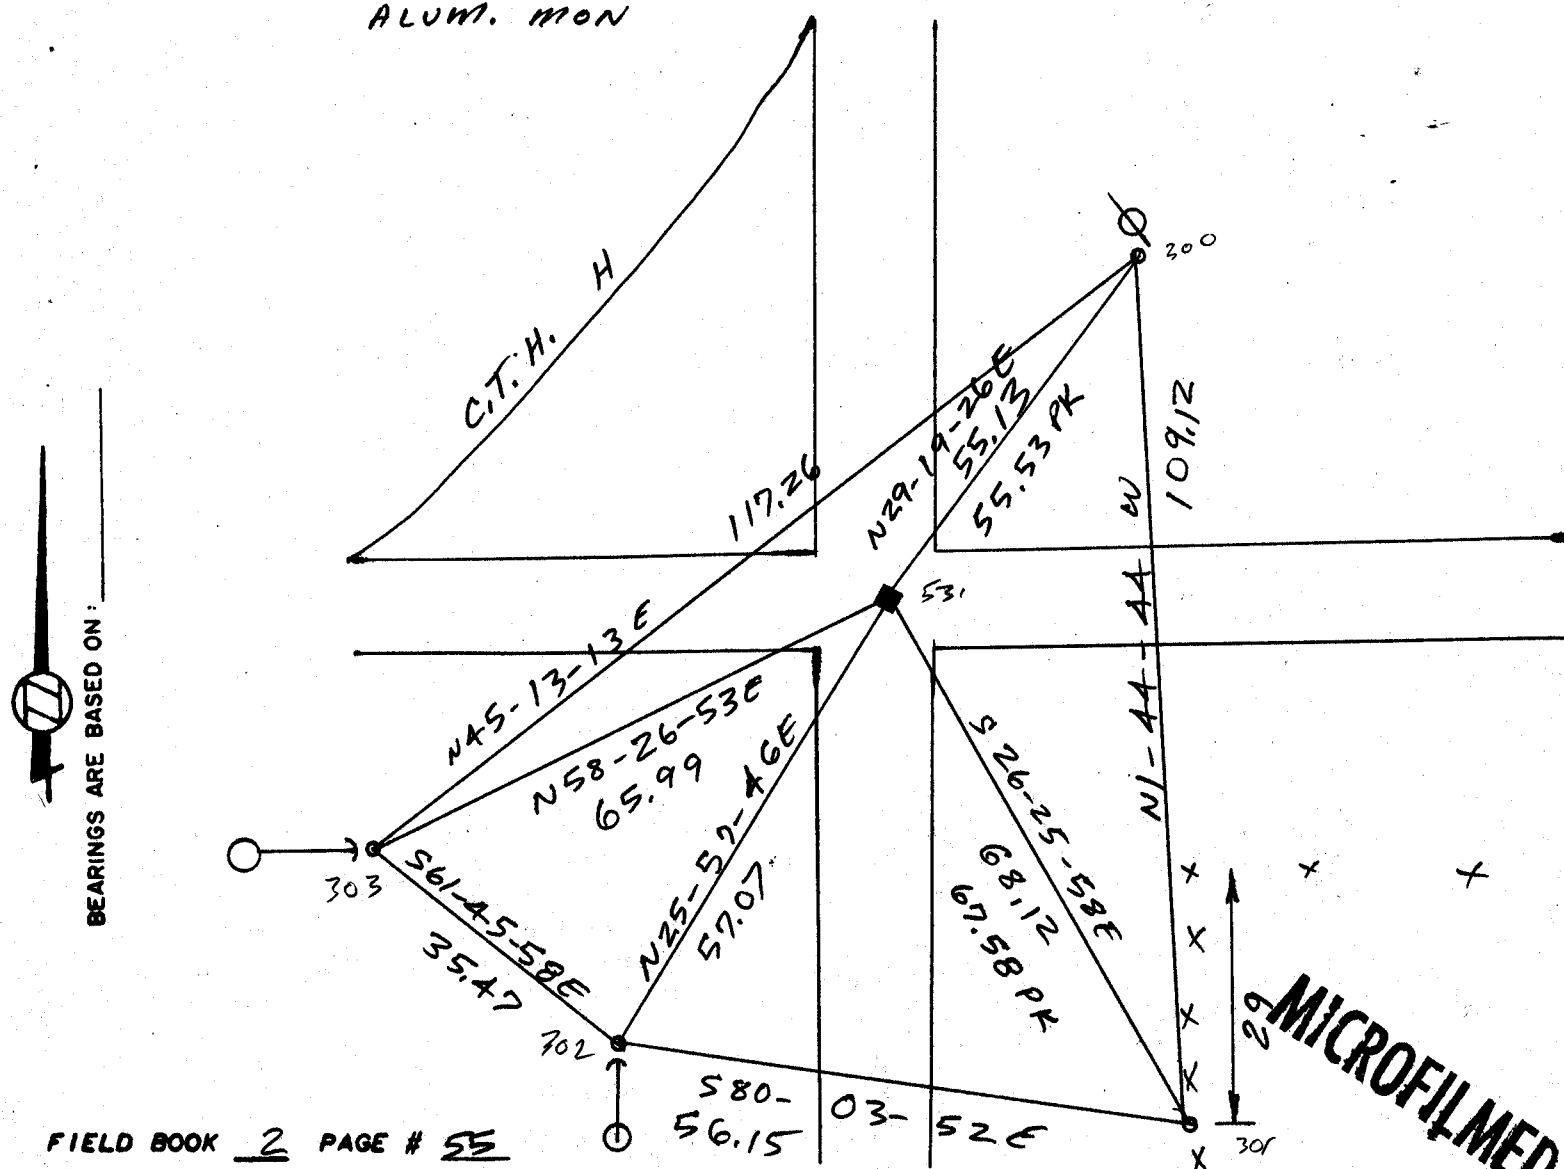

FIELD BOOK 2 PAGE # 55

SHOW A PLAN VIEW DRAWING DEPICTING THE CORNER MONUMENT AND SURROUNDING PHYSICAL FEATURES, INCLUDING THE EXCAVATION AREA AND DEPTH. THE CORNER MONUMENT SHALL HAVE THE FOLLOWING CHARACTERISTICS: 1) HAVE AT LEAST TWO PREDETERMINED BREAK-OFF POINTS. 2) IF BROKEN, LEAVE A PERMANENTLY MAGNETIZED REMNANT AT THE ORIGINAL POINT. 3) MUST BE EXTENDABLE. 4) THE CAP IS INSCRIBED: ROCK COUNTY SURVEY MONUMENT - PENALTY FOR DISTURBING MARKER. 5) OR AN EXISTING CUT LIMESTONE. AN IRON PIPE 1 1/2" x 4'0" (MINIMUM) MAY BE USED IN AREAS WHERE GROUND WATER IS WITHIN ONE FOOT OF THE SURFACE. IF THE CORNER IS OCCUPIED BY AN IMPROVEMENT (MANHOLE, BURIED CABLE, ETC.) ANY DURABLE, DISTINCT MONUMENT MAY BE USED. CORNERS SHALL BE REFERENCED WITH AT LEAST 4 DURABLE WITNESS MONUMENTS. WITNESS MONUMENTS SHALL BE MADE OF CONCRETE, NATURAL STONE, IRON OR OTHER EQUALLY DURABLE MATERIAL, EXCEPT WOOD. DESCRIBE THE CORNER AND THE WITNESS MONUMENTS.

CORNER CODE: E 21

(b.) Describe any record evidence, monument evidence, occupational evidence, testimonial evidence or any other material evidence you considered, and whether the monument was found or placed.

1855 CHURCH VOL 1 PG 34 SHOWS DISTANCES TO CORNER BUT STATES NOTHING ABOUT CORNER.
1876 RUGER VOL 2 PG 205 SHOWS STONE MONUMENT
1933 SUNNY VOL 3 PG 234 FOUND 6 X 6 CUT LIMESTONE AND SET 1 1/4" IRON PIPE ON TOP
1933 SUNNY VOL 3 PG 235 STATES SEE PAGE 234
1938 SUNNY VOL 3 PG 291 FOUND STONE MONUMENT SET PIPE ON TOP AND SHOWS REFERENCE TIES.
1966 BATTERMAN JR. VOL 4 PG 295 SET PK BY USING SUNNY TIES.

I FOUND PK AND ABOUT 2.3' DEEP FOUND CUT LIMESTONE. THE STONE WAS SPLIT LENGTH WISE. I REMOVED THE MIDDLE SECTION AND PLACE 1x24" PIPE HORIZONTALLY ON SOUTH SIDE OF STONE. PLACE ALUMINUM MONUMENT.

(c.) Was the corner restored through acceptance of (1) an obliterated evidence location, or, (2) a found perpetuated location?


ACCEPTED FOUND PERPETUATED LOCATION.

(d.) Describe any material discrepancy between the location of the corner as restored or reestablished and the location of that corner as previously restored or reestablished by distance and direction. Show the discrepancy on the plan view drawing under (a), above. Show the distances between the corner as previously restored or reestablished and (1) the corner as restored or reestablished, and (2) to at least 4 of the witness monuments shown on the drawing in (a), above.

THERE IS A DISCREPANCY BETWEEN THE STONE AND THE PK THAT I FOUND. I ACCEPTED THE STONE. THE PK IS ABOUT .55 NORTH AND .23 WEST OF THE STONE.

(e.) Was the corner reestablished through lost corner proportionate methods? If so, show the method, including the directions and distances to other public land survey corners used as evidence or used for proportioning in determining the corner location.

I, Donald Barnes, hereby certify that the corner points as identified by the corner code index were, in a field survey on June 2 1988, established, re-established, monumented, re-monumented, recovered or restored as expressed below and in conformance with the regulations and rules as required in the current manual of survey instructions of the United States Department of Interior, Bureau of Land Management.

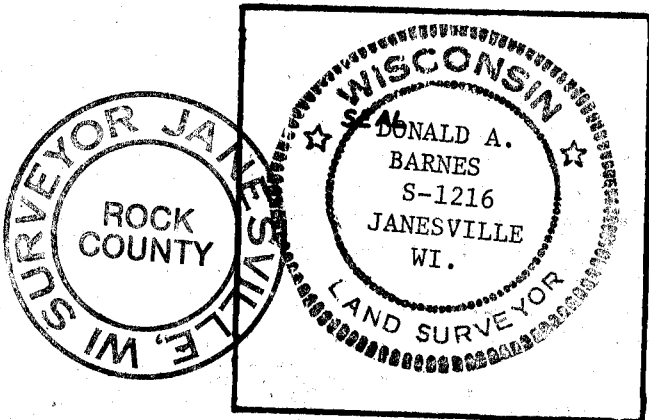

COUNTY SURVEYOR FILING DATA
Date of Computer Entry _____
Date Received _____
Date Microfilmed _____
Treasurer's Receipt No. _____
Number of Included Sheets _____

AFFIX YOUR LAND SURVEYOR SEAL. CORNER CODE E21