

PUBLIC LAND SURVEY MONUMENT RECORD


For Public Land Survey Corners in the
T. 2 N., R. 10 E.

CORNER CODE INDEX

	1	2	3	4	5	6	7	8	9	10	11	12	13	14	15	16	17	18	19	20	21	22	23	24	25
A																									
B																									
C																									
D																									
E																									
F																									
G																									
H																									
I																									
J																									
K																									
L																									
M																									
N																									
O																									
P																									
Q																									
R																									
S </td <td></td> <td></td> T																									
U																									
V																									
W																									
X																									
Y																									
Z																									

PLACE MONUMENT SYMBOL (◊) AT PROPER LOCATION ON ABOVE INDEX

EXAMPLE

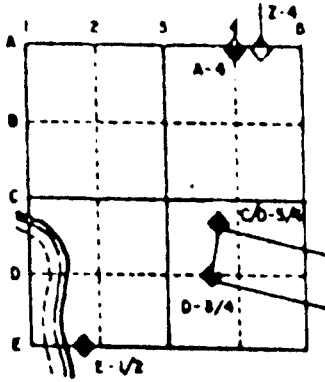


Spring Valley TWP
ROCK COUNTY WI

IF AVAILABLE
STATE PLANE COORDINATES

North (Y) _____ Elev. (Z) _____
 East (X) _____ Zone _____
 Hor. Datum _____ Vert. Datum _____

◊ CORNER MONUMENT

○ WITNESS MONUMENT

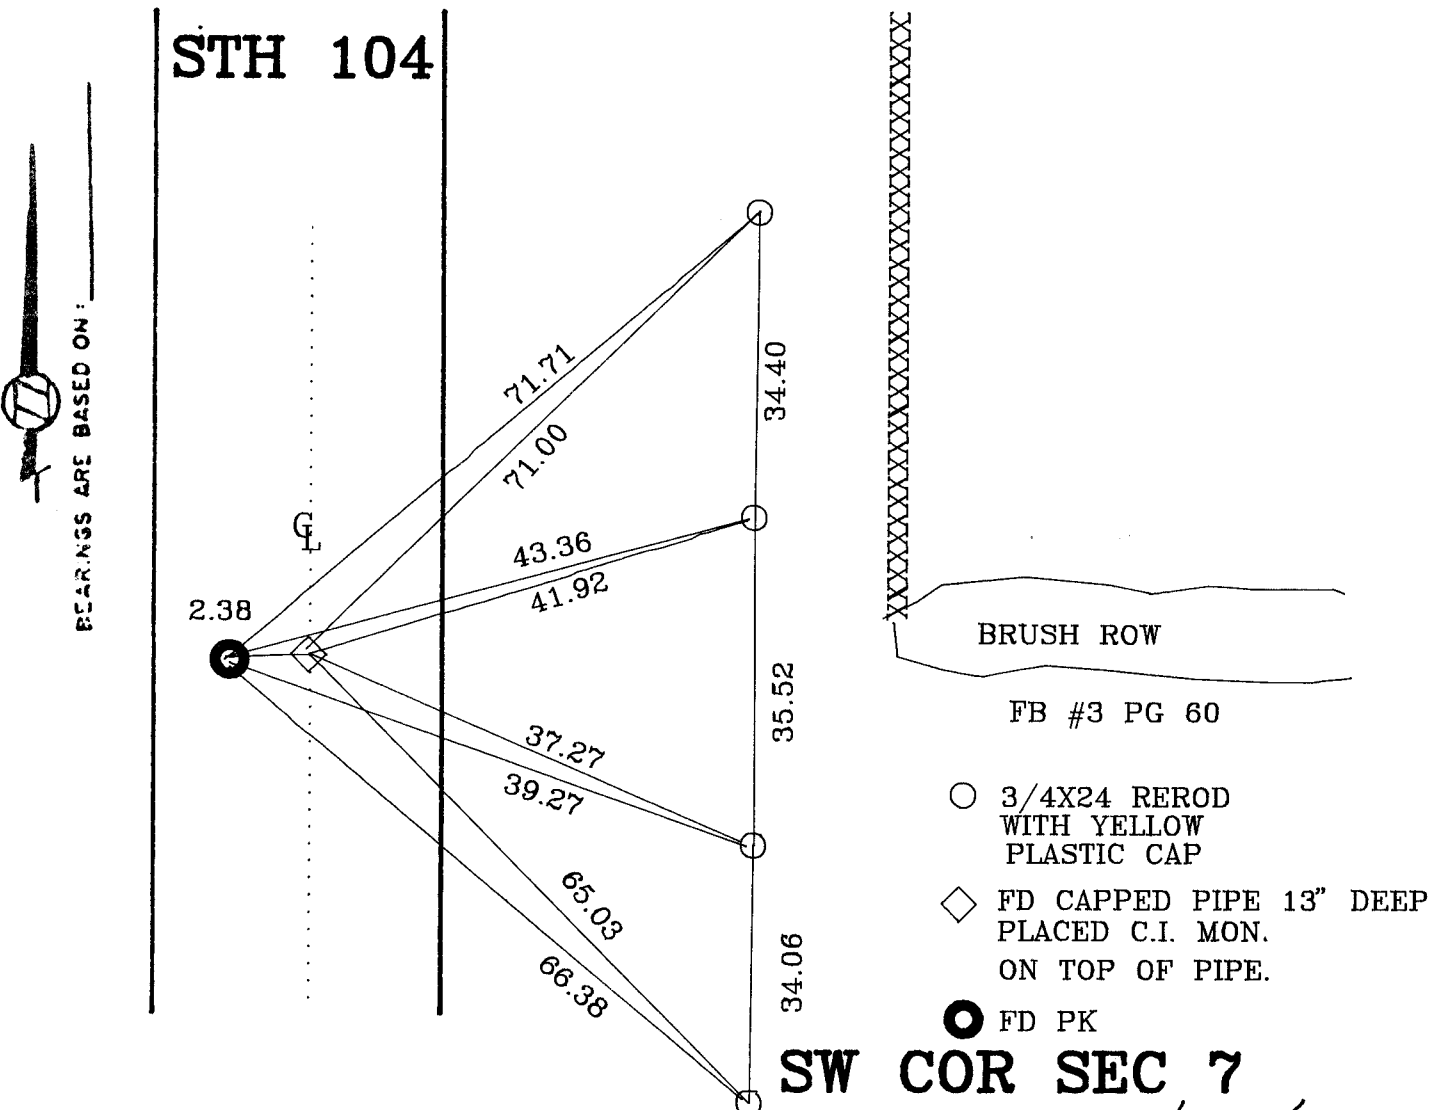

SHEET 1 OF 1

CORNER CODE: 51

(B) Describe any record evidence, monument evidence, occupational evidence, testimonial evidence or any other material evidence you considered, and whether the monument was found or placed.

- 1834 MILLER ORIG SURVEYOR INTERSECTED RANGE LINE 1160.28' NORTH OF POST. LAND LEVEL, 2ND RATE. SET POST CORNER OF SECTION 7 & 18 B.O. 14" S88-30E 234.3', B.O 14" S76E 267.96'
- 1866 LOCKE VOL 1 PG 255 FOUND EAST BEARING TREE. SET SAKE & SURROUNDED IT BY 3 LARGE HH. 2635.51' TO W 1/4 CORNER OF SECTION 18.
- 1868 LEE VOL 1 PG 336 FOUND OLD STAKE. 2612.54' TO W 1/4 CORNER OF SEC 7.
- 1879 RUGER VOL 2 PG 265 FOUND REMAINS OF OLD STAKE. ALSO FOUND THE WITNESS TREE S88 1/2E 234.3'. ALSO WHERE THE STUMP HAD BEEN DUG OUT. IT IS S66E 265.98' INSTEAD OF S76E 269.94' AS GIVEN IN NOTES. THE CORNER ESTABLISHED BY ME IS 13.86' SOUTH OF CORNER ESTABLISHED BY LOCKE. HIS CORNER WOULD NOT AGREE WITH WITNESS TREE NOTES. HE DID NOT FIND CORNER. SET HH 24X19X9 ON TOP OF STAKE DRIVEN DEEP. 2621.52' TO W 1/4 CORNER OF SECTION 7 & 2644.29' TO S 1/4 CORNER OF SECTION 7.
- 1937 SUNNY VOL 3 PG 355 DUG 4X6X3.5 DEEP HOLE. FOUND NO MONUMENT SET BY RUGER IN 1879.
- 1967 COMBS FIELD BK 136 PG 48 FOUND CAPPED PIPE 1313.3 TO FENCE TO NORTH, 2626.6 TO FENCE AT W 1/4 CORNER OF SEC 7, & 23655 TO FENCE AT S 1/4 CORNER OF SECTION 7.
- 1967 LEE MAP #44462 FOUND CAPPED PIPE. 3968 TO FENCE INTERSECTION AT S 1/16 OF SE 1/4 COR OF SEC 7.

C) Was the corner restored through acceptance of (1) an obliterated evidence location, or, (2) a found perpetuated location?

D) Describe any material discrepancy between the location of the corner as restored or reestablished and the location of that corner as previously restored or reestablished by distance and direction. Show the discrepancy on the plan view drawing under (a), above. Show the distances between the corner as previously restored or reestablished and (1) the corner as restored or reestablished, and (2) to at least 4 of the witness monuments shown on the drawing in (a), above.

(E) Was the corner reestablished through lost corner proportionate methods? If so, show the method, including the directions and distances to other public land survey corners used as evidence or used for proportioning the corner location.

NO

I, Donald Barnes, hereby certify that the corner points as identified by the corner code index were, in a field survey on, August 5, 1994, established, re-established, monumented, re-monumented, recovered or restored as expressed below and in conformance with the regulations and rules as required in the current manual of survey instructions of the United States Department of Interior, Bureau of Land Management.

COUNTY SURVEYOR FILING DATA

Date of computer entry _____

Date microfilmed _____

Number of included sheets _____

CORNER CODE

Donald Barnes
seal
AUG 10, 1994

AFFIX YOUR LAND SURVEYOR SEAL