U.S.


PUBLIC LAND SUR MONUMENT RECORD

For Public Land Survey Corners in:

WI ADMINISTRATIVE CODE A-E 7.08 REQUIREMENT

T.Z.N., R. 10 E

CORNER CODE INDEX

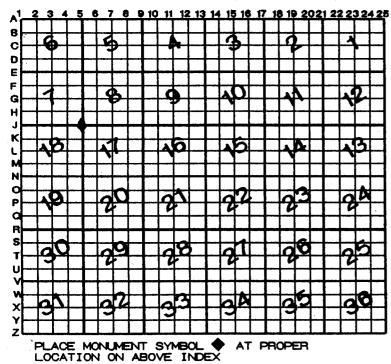

SPRING VALLEY TWP

IF AVAILABLE ROCK COUNTY COORDINATES PERFERRED

North	Elev
East	
Hor. Datum	Vert. Datum
LATITUDE	ELLIPS. H
LONGITUTE	
GPS (X)	TRAVERSE (X)
BASED ON THE F	OLLOWING CONTROL:

◆CORNER MONUMENT

O WITNESS MONUMENT

BEARINGS ARE BASED ON:

(a)

SHEET \_\_\_\_ CONTINUE OF SHEET \_\_\_ CONTINUE OF SHEET \_\_\_\_ CONTINUE OF SHEET \_\_\_ CONTINUE OF SHEET \_\_\_\_ CONTINUE OF SHEET \_\_\_\_ CONTINUE OF SHEET \_\_\_\_\_ CONTINUE OF SHEET \_\_\_\_\_ CONTINUE OF SHEET \_\_\_\_\_\_ CONTINUE OF SHEET \_\_\_\_\_\_\_ CONTINUE OF SHEET \_

CORNER CODE 75

- Describe any record evidence, monument evidence, occupational evidence, testimonial evidence or any other material evidence you considered, and whether the monument was found or placed.
- 1833 MILLER NORTH BETWEEN 17 & 18

330' LEAVE MARSH

448.8 YEL. O. 8 IN.

1374.12 BUR O. 12 IN DIA.

2112 ENTER CREEK BOTTOM 2640 SET 1/4 SEC POST. BUR OA. 16 S45W 607.2'; BUR OAK 15 N49W 331.98'

2887.5 BROOK 5.28' S.W.

3042.6' SAME BROOK S.E.

3102 SAME S.W.

3762 LEAVE MARSH

4227.96 BUR OAK 15

- 5280 SET POST COR 7,8,17,18 BUR OAK 10 N12W 22,44' & BUR OAK 12 S7E 24.42'
- 1855 CHURCH VOL 1 PG 42 STATES NOTHING ABOUT CORNER BUT CALLS FOR 2674.32' TO S 1/4 COR SEC 8
- 1866 LOCKE VOL 1 PG 256 FOUND B.T.s & STAKE. VAR 8-15 TO W 1/4 COR SEC
- 1866 LOCKE VOL 1 PG 257 FOUND CORNER SET BY SELF. VAR 8-15 2647.92 TO W 1/4 COR SEC 8, VAR 6-45 2618.88 TO S 1/4 COR SEC 8; SET STAKE WITH HH ON N,S,E,&W 589.25' WEST OF S 1/4 COR SEC 8.
- 1866 LOCKE VOL 1 PG 255 FOUND B.T.s & OLD STAKE. VAR 8-00 2628.12 TO N 1/4 COR SEC 18 & VAR 8-50 2639.34 TO E 1/4 COR SEC 18. E 1/4 COR SEC 18 ESTABLISHED MIDWAY AND ON LINE WITH SE & NE CORNERS OF SEC 18.
- 1868 LEE VOL 1 PG 336 FOUND STAKE SET BY LOCKE ON SEC 8. VAR 8-00 2654.52 TO E 1/4 COR SEC 7.
- 1879 RUGER VOL 2 PG 265 FOUND WIT. TREES ALSO FOUND COR. SET BY LOCKE CORRECT. DROVE NEW STAKE IN PLACE OF OLD ONE. VAR 6-49 2644.46 TO E 1/4 COR SEC 7, VAR 5-35 2621.20 TO S 1/4 COR SEC 7, & 5265.49 TO SW COR SEC 7.
- 196? COMBS FB 136 PG 48 1315 FROM N/S FENCE NEAR S 1/16TH CORNER OF SE 1/4 OF SEC 7 TO N/S FENCE NEAR SW COR SEC 8, 2630 FROM N/S FENCE NEAR S 1/4 COR SEC 7 TO N/S FENCE NEAR SW COR SEC 8, 1314.3 FROM N/S FENCE NEAR SW COR SEC 8 TO N/S FENCE NEAR S 1/16TH COR OF SE 1/4 OF SEC 7, & 2641 FROM N/S FENCE NEAR SW COR SEC 8 TO N/S FENCE NEAR N 1/4 COR SEC 17.
- DUG LONG 2.5' DEEP HOLE ON EAST SIDE OF N/S FENCE WITH BACK HOE. FOUND 17X8X4 L.S., 11X3X8 L.S., 11X8X3 L.S., & TRIANGLE 14X8X4 L.S. IN CLUSTER. REPLACED L.S. WITH POLY. MONUMENT.
- Was the corner restored through acceptance of (1) an obliterated evidence location, or, (2) a found perpetuated location? ACCEPTED FOUND LIMESTONES. THEY ARE IN HARMONY WITH RECORD DISTANCES AND FENCES.
- (E) Was the corner reestablished through lost corner proportionate methods? If so, show the method, including the directions and distances to other public land survey corners used as evidence or used for proportioning the corner location.
- I, Donald Barnes, hereby certify that the corner location as identified by the corner code index was determined by me under by direction and control and that this U.S. Public Land Survey Monument Record is correct and complete to the best of my knowledge and belief.

Number of included sheets

CORNER CODE

## U.S.

(a)

COUNTY PROJECTION

ÿ O

BASED

BEARINGS ARE

## LAND PUBLIC MONUMENT RECORD


SUR

For Public Land Survey Corners in:

WI ADMINISTRATIVE CODE A-E 7.08 REQUIREMENT

T. 2N., R. 10 E

CORNER CODE INDEX

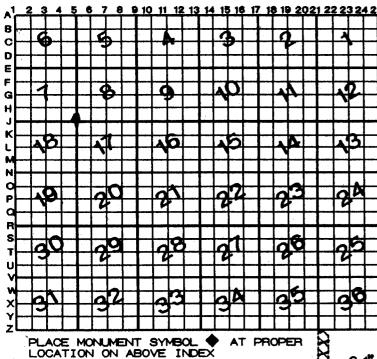

## SPRING VALLEY TWP ROCK COUNTY WI

IF AVAILABLE ROCK COUNTY COORDINATES PERFERRED

North Elev. East

Hor. Datum \_\_\_\_\_ Vert. Datum

LATITUDE \_ELLIPS. HT.

GPS (X) \_\_\_ TRAVERSE (X) \_


BASED ON THE FOLLOWING CONTROL:

UME	INE	SYM		•	AT	PROPER
ON	ABC	)VE	IND	ΞX		

<b>♦</b> CORNE	R MO	NUMEN"

WITNESS MONUMENT

LONGITUTE

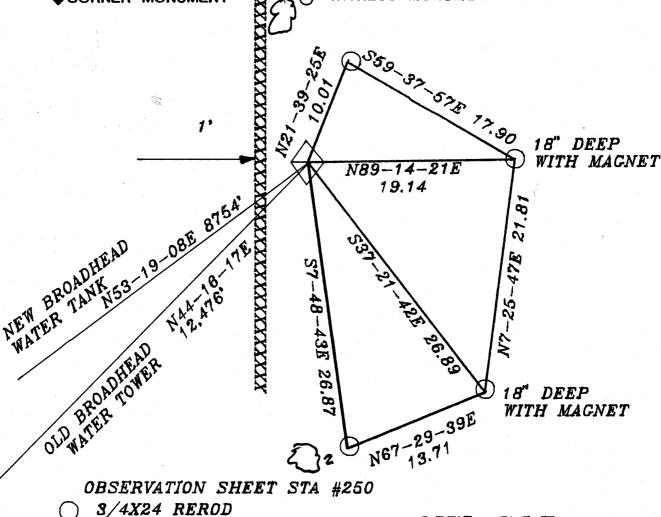

24"

OAK

Dec 2,1996

POLY. MON. WITH CARSONITE POST.

NW COR SEC 17

FIELD BOOK \_PAGE # .

SHEET Z

SHOW A PLAN VIEW DRAWING DEPICTING THE CORNER MONUMENT AND SURROUNDING PHYSICAL FEATURES, INCLUDING THE EXCAVATION AREA AND DEPTH.

PLANNING & ZONING COMMITTEE ADOPTED THE ABOVE FORM ON 12/2/1982

NE COR S89-03-54E 2759.62 S89-45-58E 2624.25 HLS

Donal Baces Dec 2, 1996

75