

# U.S. PUBLIC LAND SURVEY MONUMENT RECORD

For Public Land Survey Corners in:  
T. 2 N., R. 10 E 4th P.M.  
CORNER CODE INDEX

WI ADMINISTRATIVE CODE A-E 7.08 REQUIREMENT

Spring Valley TWP

ROCK COUNTY, WI

IF AVAILABLE  
ROCK COUNTY COORDINATES PREFERRED

	1	2	3	4	5	6	7	8	9	10	11	12	13	14	15	16	17	18	19	20	21	22	23	24	25
A																									
B	6																								
C		5																							
D			4																						
E				3																					
F					2																				
G						1																			
H	7																								
I		8																							
J			9																						
K				10																					
L					11																				
M						12																			
N	18																								
O		17																							
P			16																						
Q				15																					
R					14																				
S						13																			
T							12																		
U								11																	
V									10																
W										9															
X											8														
Y												7													
Z													6												

North 224861.87' Elev. 946.36'

East 2157625.73'

Hor. Datum NAD 83/91 Vert. Datum NGVD 29

LATITUDE 42°-36'-53.138144" ELLIPS. HT.

LONGITUDE 89°-17'-50.748719"

ELLIPS. DATUM

NAD83(91)  COUNTY      LIST     

GPS (X)  TRAVERSE (X)     

BASED ON THE FOLLOWING CONTROL:

Rock Co. Brodhead GPS Sta. #0209E258

PLACE MONUMENT SYMBOL  AT PROPER LOCATION ON ABOVE INDEX

 CORNER MONUMENT


WITNESS MONUMENT

(a)

 = Aluminum monumnet found 1' below surface.

BEARINGS ARE BASED ON: compass readings

- RM 1 - Fnd 3/4" rebar ± 18' E of E.E.O. Rd. & ± 33' N of N.E.O. Rd. N47°E  
46.84'
- RM 2 - PK set NE face of PP #4B27E 1  
± 3' AGL S36°E  
57.34'
- RM 3 - PK set E face of PP #4B27W 1  
± 2' AGL S30°W  
53.40'
- RM 4 - Set 3/4" rebar ± 20' N & 3" W of N. E. of field LN N22°W  
21.09'

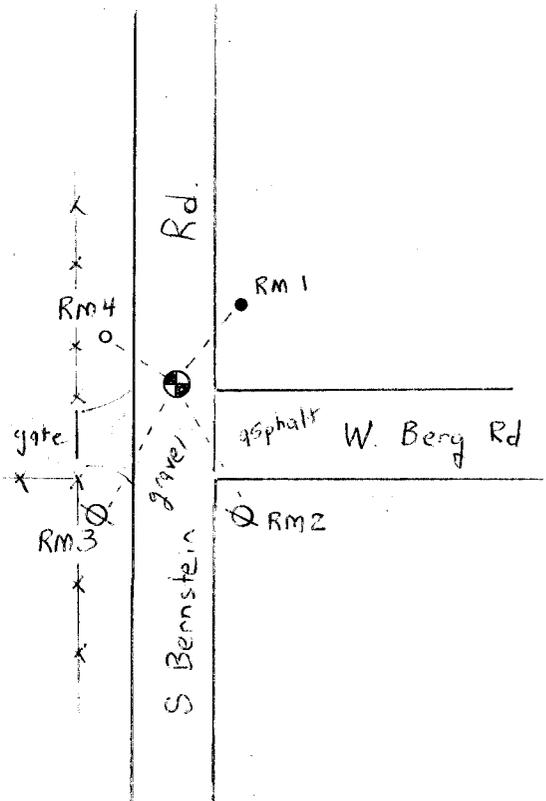

FIELD BOOK P-196 PAGE # 29

SHEET 1 OF 1

SHOW A PLAN VIEW DRAWING DEPICTING THE CORNER MONUMENT AND SURROUNDING PHYSICAL FEATURES, INCLUDING THE EXCAVATION AREA AND DEPTH.

PLANNING & ZONING COMMITTEE ADOPTED THE ABOVE FORM ON 12/2/1982

CORNER CODE R-15

B) Describe any record evidence, monument evidence, occupational evidence, testimonial evidence or any other material evidence you considered, and whether the monument was found or placed.

Dug and found an aluminum monument 1' below the road surface.

C) Was the corner restored through acceptance of (1) an obliterated evidence location, or, (2) a found perpetuated location?

(2) found perpetuated lo<sup>e</sup>ation.

D) Describe any material discrepancy between the location of the Corner as restored or reestablished and the location of that corner as previously restored or reestablished by distance and direction. Show the discrepancy on the plan view drawing under (a), above. Show the distances between the corner as previously restored or reestablished and (1) the corner as restored or reestablished, and (2) to at least 4 of the witness monuments shown on the drawing in (a), above.

E) Was the corner reestablished through lost corner proportionate methods? If so, show the method, including the directions and distances to other public land survey corners used as evidence or used for proportioning the corner location.

I, Anthony P. Lulloff, hereby certify that the corner location as identified by the corner code index was determined by me under by direction and control and that this U.S. Public Land Survey Monument Record is correct and complete to the best of my knowledge and belief.

seal

emboss/stamped

*Anthony P. Lulloff*  
*12/28/98*

Number of included sheets 2