

U.S. PUBLIC LAND SURVEY MONUMENT RECORD


For Public Land Survey Corners in the
T. 2 N., R. 10 E.

CORNER CODE INDEX

	1	2	3	4	5	6	7	8	9	10	11	12	13	14	15	16	17	18	19	20	21	22	23	24	25
A																									
B																									
C	6																								
D		5																							
E			4																						
F				3																					
G					2																				
H																									
I	7																								
J		6																							
K			5																						
L				4																					
M					3																				
N						2																			
O	7																								
P		6																							
Q			5																						
R				4																					
S					3																				
T	30																								
U		29																							
V			28																						
W				27																					
X					26																				
Y						25																			
Z							24																		
								23																	
									22																
										21															
PLACE MONUMENT SYMBOL (◆) AT PROPER LOCATION ON ABOVE INDEX

EXAMPLE

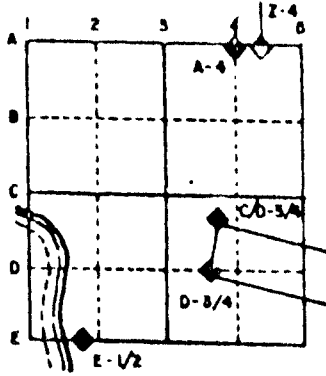

SPRING VALLEY TWP
ROCK COUNTY WI

IF AVAILABLE
STATE PLANE COORDINATES


North (Y) _____ Eleve. (Z) _____
 East (X) _____ Zone _____
 Hor. Datum _____ Vert. Datum _____

◆ CORNER MONUMENT ○ WITNESS MONUMENT

C.T.H. "T"

FIELD BOOK #3 PG 47

BEARINGS ARE BASED ON: ASSUMED

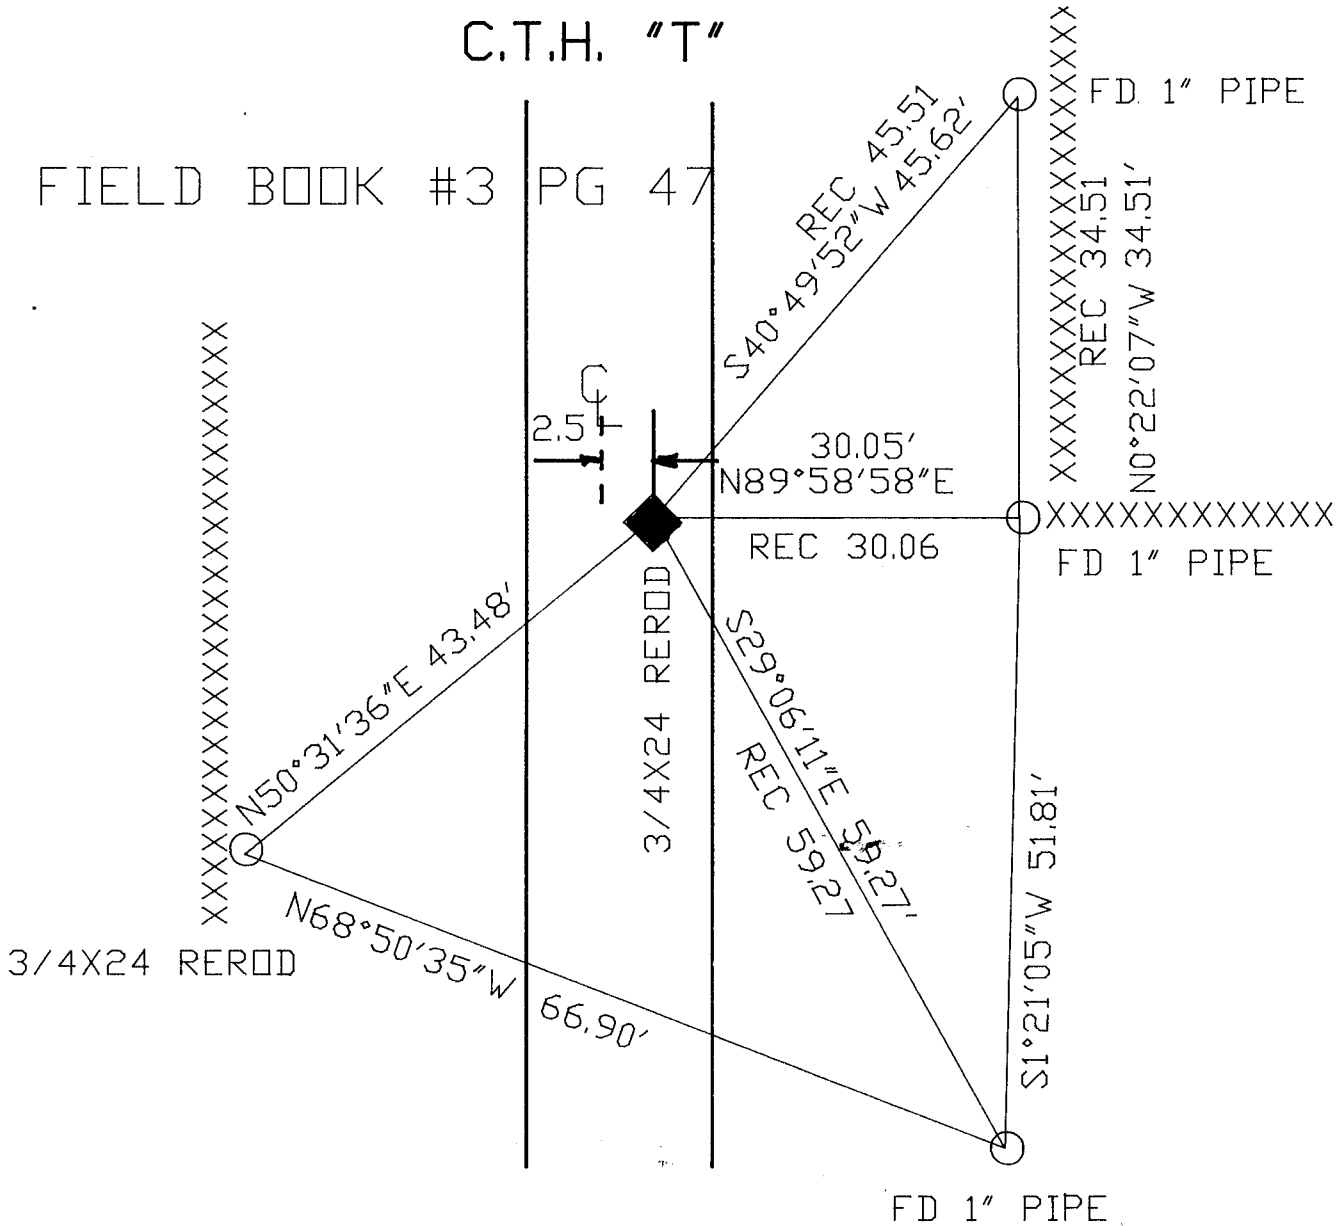

(B) Describe any record evidence, monument evidence, occupational evidence, testimonial evidence or any other material evidence you considered, and whether the monument was found or placed.

1869 LEE VOL 1 PG 351 SET LIMESTONE. CALLS FOR 1324.29 TO NW CORNER, 1324.29 TO W 1/4 CORNER, AND 1521.96 TO CENTER OF NW 1/4 OF SECTION 30.

1877 RUGER VOL 2 PG 267 FOUND LIMESTONE AT COR SET BY LEE. CALLS FOR 1325.78 TO W 1/4 CORNER, 1325.78 TO NW CORNER, AND 1521.96 TO CENTER OF NW 1/4 OF SECTION 30.

1963 BATTERMAN JR. VOL 4 PG 159 FOUND LIMESTONE MON. REFERENCED SAME.

DUG AND FOUND 5X10X17 LIMESTONE ON END 2' DEEP. PLACED MAGNET ON EAST SIDE AND REFERENCED SAME. MONUMENT IS 3.5 EAST OF THE CENTER OF THE PAVEMENT.


C) Was the corner restored through acceptance of (1) an obliterated evidence location, or, (2) a found perpetuated location?

ACCEPTED FOUND PERPETUATED LOCATION.

D) Describe any material discrepancy between the location of the corner as restored or reestablished and the location of that corner as previously restored or reestablished by distance and direction. Show the discrepancy on the plan view drawing under (a), above. Show the distances between the corner as previously restored or reestablished and (1) the corner as restored or reestablished, and (2) to at least 4 of the witness monuments shown on the drawing in (a), above.

(E) Was the corner reestablished through lost corner proportionate methods? If so, show the method, including the directions and distances to other public land survey corners used as evidence or used for proportioning the corner location.

I, Donald Barnes, hereby certify that the corner points as identified by the corner code index were, in a field survey on, AUGUST 3 1991, established, re-established, monumented, re-monumented, recovered or restored as expressed below and in conformance with the regulations and rules as required in the current manual of survey instructions of the United States Department of Interior, Bureau of Land Management.

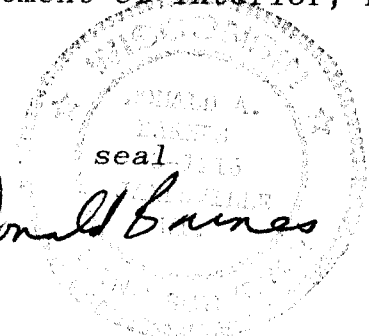

COUNTY SURVEYOR FILING DATA

Date of computer entry _____

Date microfilmed _____

Number of included sheets 1
CORNER CODE

AFFIX YOUR LAND SURVEYOR SEAL

THE G. B. BARNES COMPANY, ST. LOUIS

W 1/4 COR

BARNES 1984 1485.37

SEC 19

◇ COMPUTED POSITION WHICH MAY NOT REPRESENT THE ACTUAL CORNER AS MONUMENTED.
□ USED PREVIOUS FIELD MEASUREMENTS TO COMPUTE THE LOCATION.

NW COR

1/16TH COR

RUGER 1877 1499.52
ORIG 2831.14
S87-54-12E 1500.71
1499.52 LEE 1869 VAR 6-54
BARNES 1984 S87-54-12E 1500.63
1308.78 LEE 1869 VAR 6-54
S87-53-55E 1310.10
BARNES 1984 1310.10
ORIG 2640
1320.79 BARNES 1984 1320.79
1318.68 LEE 1869 1318.68 VAR 6-40
S88-03-13E 2641.44

SI-30-19V 2693.79

NE COR
SEC 36 ALUM

SI-38-57W 1168.43
ORIG 1117.38

1/16TH STONE

RUGER 1877 1325.78
SI-27-30V 1326.61
RUGER 1877 1325.78
SI-26-52V 1329.78
1323.24
RUGER 1877 1521.96
LEE 1869 1521.96
1313.16
NO-28-22E 1326.28
1326.60 LEE 1869
NO-28-22E 1331.60

SI-26-13V 2625.63

W 1/4 COR
POLY

LEE 1869 2648.58 VAR 7-45
SI-27-30V 1326.61
RUGER 1877 1325.78
LEE 1869 2648.58 VAR 7-45
SI-27-30W 2629.40
LEE 1869 2655.84 VAR 7-45

1544.40 LEE 1869
S87-53-50E 1546.18 STONE
RUGER 1877 1544.40
1/16TH FENCE INT.
RUGER 1877 1326.60
S88-24E 1312.

KERCH 1335
BARNES 1976 1335 (FENCE)
LEE 1869 1336.01
1334.9
KERCH 1335
LEE 1869 1336.01
1335 FENCE

E 1/4 COR
POLY

KERCH 333.75
334
KERCH 1668.75
S88-00E 1668.4 (FENCE)

KERCH 1001.25
S88-18E 1001.2
(FENCE)
2640.88 1/4 LINE
2637.9 FENCE INT
KERCH 1911 2640.7

SI-16-39E 2643.81
CHURCH 1855 2649.24

E 1/4 COR
SEC 36 ALUM
SI-20-23W 1519.84

SW COR

MON BOX
BARNES 1976 2903.3
LEE 1869 1888.62
ORIG 2913.90
S88-41-09E 2905.74
LEE 1869 2904.0

LEE 1869 1315.38
S 1/4 COR

BARNES 1976 2674.5
KERCH 1911 2673.8
S87-44-54E 2674.47
ORIG 2640

SE COR

SE COR
SEC 36

ORIG 1133.88
ALUM

W 1/4 COR

SEC 31

BARNES 1976 1326.02
RUGER 1874 1324.13

