

PUBLIC LAND SURVEY MONUMENT RECORD


For Public Land Survey Corners in the
T. 2 N., R. 10 E.

CORNER CODE INDEX

	1	2	3	4	5	6	7	8	9	10	11	12	13	14	15	16	17	18	19	20	21	22	23	24	25
A																									
B																									
C	6																								
D		5																							
E			4																						
F				3																					
G					2																				
H	7																								
I		6																							
J			5																						
K				4																					
L					3																				
M	16																								
N		15																							
O			14																						
P				13																					
Q	19																								
R		20																							
S			21																						
T				22																					
U					23																				
V						24																			
W	30																								
X		29																							
Y			28																						
Z				27																					
					26																				
						25																			
							24																		
PLACE MONUMENT SYMBOL (●) AT PROPER LOCATION ON ABOVE INDEX

EXAMPLE

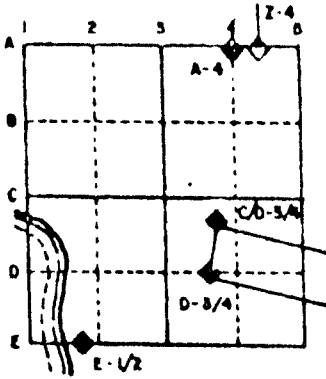


SPRING VALLEY WP
ROCK COUNTY WI

IF AVAILABLE
STATE PLANE COORDINATES

North (Y) _____ Elev. (Z) _____
 East (X) _____ Zone _____
 Hor. Datum _____ Vert. Datum _____

◆ CORNER MONUMENT ○ WITNESS MONUMENT

BEARINGS ARE BASED ON: **ASSUMED**

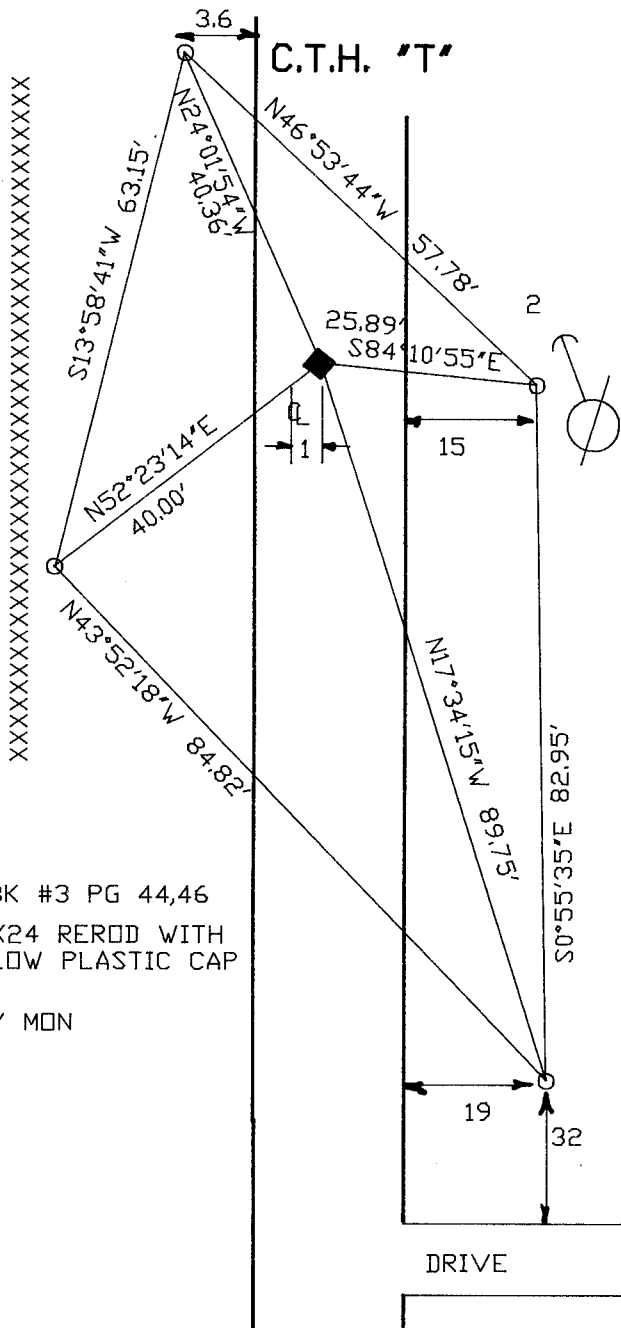

- FIELD BK #3 PG 44,46
- 3/4X24 REROD WITH YELLOW PLASTIC CAP
- ◆ POLY MON

MICROFILMED

SHEET 1 OF 2

CORNER CODE: T1

(B) Describe any record evidence, monument evidence, occupational evidence, testimonial evidence or any other material evidence you considered, and whether the monument was found or placed.

1869 LEE VOL 1 PG 351 LIMESTONE 20X7X2.5. SHOWS A VAR 7-45 ON WEST LINE OF THE SW AND NW QUARTER OF SECTION 30, 1327.92 TO THE W 1/16TH CORNER OF THE SW 1/4, 1324.29 TO THE W 1/16TH CORNER OF THE NW 1/4, AND 1521.96 TO THE S 1/16TH CORNER OF THE NW 1/4 OF SECTION 30.

1877 RUGER VOL 2 PG 267 LIMESTONE 20X7X2.5. CALLS FOR 1554.40 TO THE E 1/16TH AND 1325.78 TO THE N 1/16TH CORNERS OF SECTION 30.

DUG AND FOUND OLD PIECES OF ASPHALT TO A DEPTH OF 5'. DID NOT FIND STONE OF RECORD. PLACED POLY. MONUMENT ON LINE BETWEEN THE SW CORNER AND W 1/16TH CORNER OF THE NW 1/4 OF SECTION 30 AT PROPRATED DISTANCE WITH LEE.


C) Was the corner restored through acceptance of (1) an obliterated evidence location, or, (2) a found perpetuated location?

RESTORED CORNER THROUGH ACCEPTANCE OF OBLITERATED EVIDENCE LOCATION.

D) Describe any material discrepancy between the location of the corner as restored or reestablished and the location of that corner as previously restored or reestablished by distance and direction. Show the discrepancy on the plan view drawing under (a), above. Show the distances between the corner as previously restored or reestablished and (1) the corner as restored or reestablished, and (2) to at least 4 of the witness monuments shown on the drawing in (a), above.

(E) Was the corner reestablished through lost corner proportionate methods? If so, show the method, including the directions and distances to other public land survey corners used as evidence or used for proportioning the corner location.

I, Donald Barnes, hereby certify that the corner points as identified by the corner code index were, in a field survey on, AUGUST 3 1991, established, re-established, monumented, re-monumented, recovered or restored as expressed below and in conformance with the regulations and rules as required in the current manual of survey instructions of the United States Department of Interior, Bureau of Land Management.

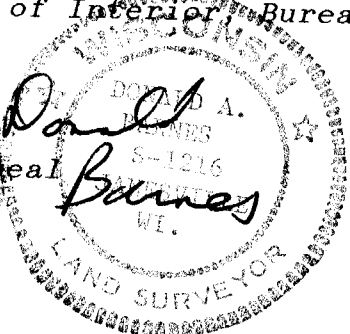

COUNTY SURVEYOR FILING DATA

Date of computer entry _____

Date microfilmed _____

Number of included sheets 1
CORNER CODE

AFFIX YOUR LAND SURVEYOR SEAL

T/

SEC 19

COMPUTED POSITION WHICH MAY NOT REPRESENT THE ACTUAL CORNER AS MONUMENTED.
USED PREVIOUS FIELD MEASUREMENTS TO COMPUTE THE LOCATION.

W 1/4 COR

BARNES 1984 1485.37

NW COR

RUGER 1877 1499.52
ORIG 2831.14
S87-54-12E 1500.71
1499.52 LEE 1869 VAR 6-54
BARNES 1984 S87-54-12E 1500.63

1/16TH COR

1308.78 LEE 1869 VAR 6-54
S87-53-55E 1310.10
BARNES 1984 1310.10

ORIG 2640
1300.78 BARNES 1984 1300.77
1300.78 LEE 1869 1310.68 VAR 6-40
S88-03-13E 2641.44

SI-30-19V 2653.79

1311.10 BARNES 1984 1311.10

CI

NE COR
SEC 36 ALUM

SI-38-57W 1168.43
ORIG 1117.38

1/16TH STONE

RUGER 1877 1325.78
SI-26-52W 1329.78
RUGER 1877 1325.78
SI-27-30V 1326.61
RUGER 1877 1325.78

1523.24
RUGER 1877 1521.96
LEE 1869 1521.96

R/R

NO-28-22E 1326.28

1313.16

1326.60 LEE 1869
NO-28-22E 1331.60

LEE 1869 2643.30
SO-20E 2645.7

SI-26-13V 2625.63

W 1/4 COR
POLY

LEE 1869 2648.58 VAR 7-45
SI-27-30V 1326.61
LEE 1869 2655.84 VAR 7-45

1544.40 LEE 1869
S87-53-50E 1546.18
RUGER 1877 1544.40

1/16TH

FENCE INT.

LEE 1869 2630.10
SO-30-08V 2636.48

SO-30V 2630.3

KERCH 1335
BARNES 1976 1335 (FENCE)
LEE 1869 1336.01
1334.9

LEE 1869 1336.01
KERCH 1335
1335 FENCE

E 1/4 COR
POLY

KERCH 333.75
334
KERCH 1668.75
S88-00E 1668.4 (FENCE)

KERCH 1001.25
S88-18E 1001.2
(FENCE)

2640.88 1/4 LINE
2637.9 FENCE INT
KERCH 1911 2640.7

SO-25-00V 2647.53
CHURCH 1855 2640

SW COR

BARNES 1976 2629.40
RUGER 1874 2627.13

BARNES 1976 2903.3
LEE 1869 1588.62
ORIG 2913.90
S88-41-09E 2905.74
LEE 1869 2904.0

LEE 1869 1315.38 S 1/4 COR

BARNES 1976 2674.5
KERCH 1911 2673.8
S87-44-54E 2674.47
ORIG 2640

SE COR

SE COR
SEC 36

ORIG 1133.89
ALUM

W 1/4 COR


SEC 31

SEC 30



Donald Barnes

2 OF 2

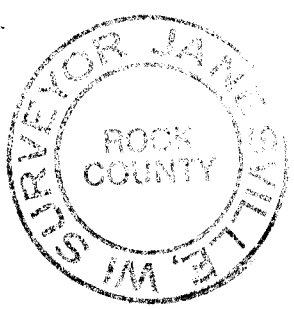

TI