
U.S. PUBLIC LAND SURVEY MONUMENT RECORD

For Public Land Survey Corners in:

WI ADMINISTRATIVE CODE A-E 7.08 REQUIREMENT

T. 2 N., R. 10 E

CORNER CODE INDEX

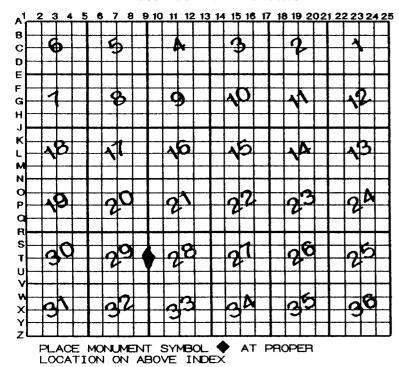

SPRING	VALLE	<u>>_T</u>	W)	F
	COUNTY			

IF AVAILABLE ROCK COUNTY COORDINATES PERFERRED

North	Elev
East	
Hor. Datum	Vert. Datum
LATITUDE	ELLIPS. H
LONGITUTE	
GPS (X)	TRAVERSE (X)
BASED ON THE	FOLLOWING CONTROL:

♦CORNER MONUMENT

WITNESS MONUMENT

BEARINGS ARE BASED ON:

(a)

	EET OF
FIELD BOOKPAGE #SH	EET OF
SHOW A PLAN VIEW DRAWING DEPICTING THE CORNER MONUMENT AND SI	JRROUNDING
PHYSICAL FEATURES, INCLUDING THE EXCAVATION AREA AND DEPTH.	
PLANNING & ZONING COMMITTEE ADOPTED THE ABOVE FORM ON 12/2/1982	
CORNER COI	DE 79

SP596

Describe any record evidence, monument evidence, occupational evidence, testimonial evidence or any other material evidence you considered, and whether the monument was found or placed.

1834 MILLER NORTH BETWEEN SEC 28 & 29

BUR OAK 16 IN DIA 574.2

BUR OAK 15" DIA 1338.48'

SET 1/4 SEC POST BUR OAK 18 S66W 58.08'; BUR OAK 12 S57-2640

30E 143.88

ENTER MARSH S.W. 2772

COR OF SEC 20,21,28,29 SET POST; BUR OAK 14 S86E 5280

14.43'; BUR OAK 18 N2-30W 6.90'

1855 CHURCH VOL 1 PG 33 1322.64 TO S 1/16TH COR OF NE 1/4 SEC 29,2645.28 TO CENTER OF SEC 29,3969.24 TO S 1/16TH COR OF NW 1/4 SEC 29; & 5293.2' TO W 1/4 COR SEC 29.

DUG AND FOUND GREY HARD HEAD 8" WIDE X 16" LONG X 5" THICK 0.5' BELOW OLD ROAD BED. HARD HEAD WAS ONLY HARD HEAD IN AREA. IT IS IN HARMONY WITH DEPRESSION WHERE BT MAY HAVE BEEN. PASTER STATED THAT A 93 YEAR OLD CHURCH MEMBER STATED THAT SHE USE TO SWING IN A SWING THAT WAS OTHER ELDERLY MEMBERS STATED THEY WERE ATTACHED TO THE BEARING TREE. THERE IS A 6' DIAMETER OAK ABOUT 15' TOLD NOT TO CUT DOWN THE TREES. WEST OF THE DEPRESSION. IT IS ALSO CLOSE TO THE PROJECTION OF THE FENCE LINE IN THE WOODS SOUTH OF THE CEMETERY. THE STONE IS 8.8' EAST OF THE LINE BETWEEN THE NW AND SW CORNERS OF SEC 28. IT IS ALSO IN HARMONY WITH CHURCH'S DISTANCE OF 2645.28 TO THE CENTER OF SEC 29. THE DISTANCE TO THE N/S 1/4 LINE OF SEC 29 IS 2646. CORNER IS 2.5' SOUTH OF CENTER OF PAVEMENT. THE DISTANCE TO THE W 1/4 COR SEC 29 IS 5318.67' WHICH IS IN HARMONY WITH CHURCH'S DISTANCE OF 5306.4.


- Was the corner restored through acceptance of (1) an obliterated evidence location, or, (2) a found perpetuated location? ACCEPTED FOUND PERPETUATED LOCATION.
- D) Describe any material discrepancy between the location of the corner as restored or reestablished and the location of that corner as previously restored or reestablished by distance and direction. Show the discrepancy on the plan view drawing under (a), above. Show the distances between the corner as previously restored or reestablished and (1) the corner as restored or reestablished, and (2) to at least 4 of the witness monuments shown on the drawing in (a), above.
- (E) Was the corner reestablished through lost corner proportionate methods? If so, show the method, including the directions and distances to other public land survey corners used as evidence or used for proportioning the corner location.
- I, Donald Barnes, hereby certify that the corner location as identified by the corner code index was determined by me under by direction and control and that this U.S. Public Land Survey Monument Record is correct and complete to the best of my knowledge and belief.

seal

Number of included sheets _

CORNER CODE

emboss
A-E 7.08 REQUIREMENT
6/25/96

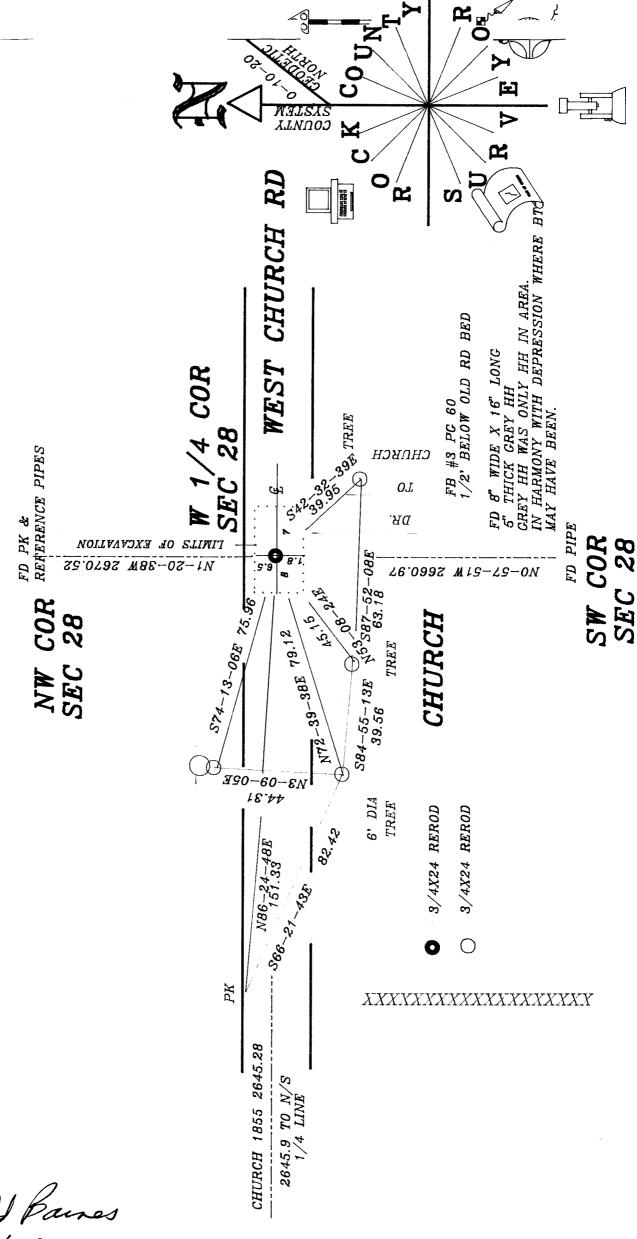

Denald Baines 6/23/96