
PUBLIC LAND U.S. SURVEY MONUMENT RECORD

For Public Land Survey Corners in:

WI ADMINISTRATIVE CODE A-E 7.08 REQUIREMENT

T. 2N., R. 10 E

CORNER CODE INDEX

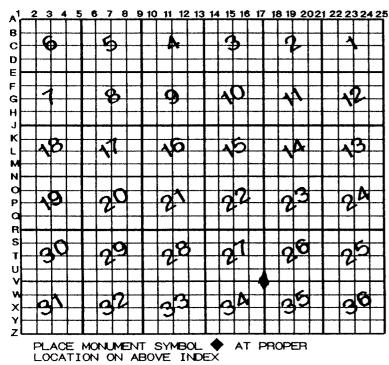

SPRING	VALLEY	TWP
	COUNTY	

IF AVAILABLE ROCK COUNTY COORDINATES PERFERRED

North	Elev
East	
Hor. Datum _	Vert. Datum
LATITUDE	ELLIPS. HT.
LONGITUTE	
GPS (X)	TRAVERSE (X)
BASED ON TH	E FOLLOWING CONTROL:

♦CORNER MONUMENT

O WITNESS MONUMENT

BEARINGS ARE BASED ON:

(a)

	,
FIELD BOOKPAGE #	SHEET $\frac{1}{2}$ OF $\frac{2}{2}$
SHOW A PLAN VIEW DRAWING DEPICTING THE CORNER MONUMENT	AND SURROUNDING
PHYSICAL FEATURES, INCLUDING THE EXCAVATION AREA AND DEPTH	1 .
PLANNING & ZONING COMMITTEE ADOPTED THE ABOVE FORM ON 12/2/1982	

SP609

(B) Describe any record evidence, monument evidence, occupational evidence, testimonial evidence or any other material evidence you considered, and whether the monument was found or placed.

NORTH BETWEEN SECS 34 & 35. 1833 HARRISON BUR OAK 16 IN 1690.92 YELLOW OAK 5 IN S10E 141.24', BUR OAK SET 1/4 SEC POST. 2640 15 IN N13-30E 227.7' ENTER MARSH @ SE 3630 LEAVE SAME 5148 SET POST COR OF SEC 27,28 BUR OAK 6 S67E 64.68'& BUR 5280 OAK 6 65W 72.6' EAST RANDOM BETWEEN SEC 26 & 35 ENTER MARSH @SW 33661

4488 LEAVE SAME

INTERSECTED SEC. LINE 9.9' SOUTH POST 5227.2 WEST CORRECTED BETWEEN SEC 26 & 35

BUR OAK 12 DIAM 2023.56

SET 1/4 SEC. POST. BUR OAK 5IN S20W 21.12'& BUR OAK 6 2613.6 S72E 35.64'

BUR OAK 15 IN DIA 3639.9

BUR OAK 12 IN DIA 4215.42

SEC COR. 5227.2

1851 McVEAN VOL 1 PG 7 STATES NOTHING ABOUT MONUMENT. COR SEC 35 & 2657.82 TO W 1/4 COR SEC 35 2630.76 TO N 1/4

1867 LOCKE VOL 1 PG 291 FD STUMPS OF BTS & OLD STAKE. SET STAKE 2663.76 VAR 7-55 TO E SURROUNDED BY 5 LIMESTONES & 1 SANDSTONE. 1/4 COR SEC 27

FOUND STAKE SURROUNDED BY L.S. & S.S. REFERENCED 1973 LEE VOL 5 PG 48 SAME. REFERENCED SAME


1973 LEE VOL 4 PG 595 SAME AS VOL 5 PG 48 BUT DIFFERENT REFERENCE MONUMENTS.

REPLACED BENT PIPE. SE PIPE WAS BENT. FOUND SE & SW REFERENCE PIPES. USED REFERENCE PIPES TO ESTABLISH CORNER. SET NEW REFERENCE MONUMENTS.

- Was the corner restored through acceptance of (1) an obliterated C) evidence location, or, (2) a found perpetuated location? ACCEPTED PERPETUATED LOCATION.
- Describe any material discrepancy between the location of the corner as restored or reestablished and the location of that corner as previously restored or reestablished by distance and direction. Show Show the the discrepancy on the plan view drawing under (a), above. Show the distances between the corner as previously restored or reestablished and (1) the corner as restored or reestablished, and (2) to at least 4 of the witness monuments shown on the drawing in (a), above.
- (E) Was the corner reestablished through lost corner proportionate methods? If so, show the method, including the directions and distances to other public land survey corners used as evidence or used for proportioning the corner location.
- I, Donald Barnes, hereby certify that the corner location as identified by the corner code index was determined by me under by direction and control and that this U.S. Public Land Survey Monument Record is correct and complete to the best of my knowledge and belief.

Number of included sheets _____

CORNER CODE

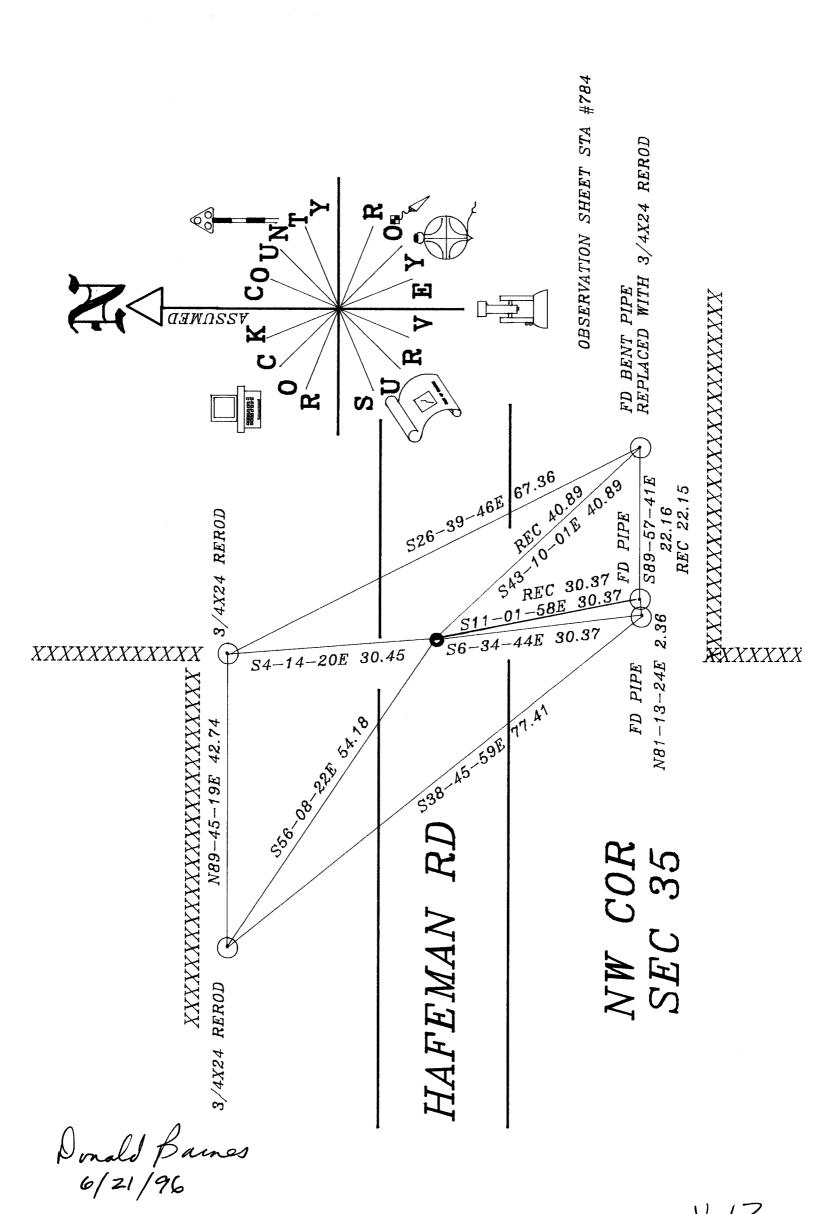

V 17