U.S.

Black nonf

equired


LAND PUBLIC SUR MONUMENT RECORD

For Public Land Survey Corners in: T. \(\times \) N. R. \(\frac{9}{2} \) E

WI ADMINISTRATIVE CODE A-E 7.08 REQUIREMENT

T. ∠N., R. _

CORNER CODE INDEX

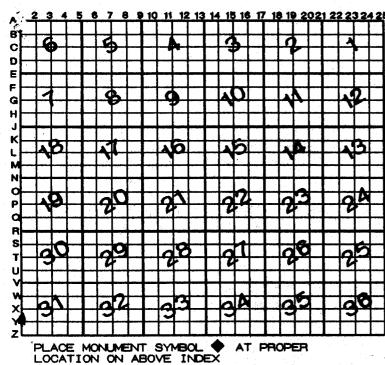

SPRING GROVE TWP GREEN ROCK COUNTY WI

> IF AVAILABLE ROCK COUNTY COORDINATES PERFERRED

North 238,084, 462 Fley 782,67

East 400,686, 792

Hor. Datum NAD83 Vert. Datum NAD29

LATITUDE 42-35-50,459263 ELLIPS. HT.

LONGITUTE 89- 22-0.369699 673,23/3

GPS (X) TRAVERSE (X)

BASED ON THE FOLLOWING CONTROL:

CORNER MONUMENT ALUM

WITNESS MONUMENT

(a)

NE / TIR9E

THE ABOVE LATITUDE & LONGITUDE WAS ACQUIRED FOR A GREEN COUNTY LAND INFORMATION PROJECT BY BOWEDEN SURVEYING COMPANY. GPS EQUIPMENT WAS USED. BOWEDEN SURVEYING COMPANY PROVIDED THE Z INFORMATION.

I COMPUTED THE COUNTY COORDINATES AND THE FOLLOW DATA FROM THE LATITUDE & LONGITUDE.

> 1.0000031866 SCALE

ANGULAR DIFFERENCE BETWEEN THE GEODETIC NORTH & ROCK COUNTY MERCATOR NORTH

0-11-57,7

BASE BEARINGS ARE

FIELD	BOOK	PAG	E #		`		SHEET		OF
SHOW	A PLAN V	IEW DRAW	ING DEPIC	CTING THE	E CORNER	MONUMENT	AND SURRO	DUNDING	
						A AND DEPT			
PLANNIN	G & ZONING	COMMITTEE	ADOPTED	THE ABOVE	FORM ON	12/2/1982 50	ZING Va	L(ey	
						CORNER			Y-1

(B) Describe any record evidence, monument evidence, occupational evidence, testimonial evidence or any other material evidence you considered, and whether the monument was found or placed.

I DID NOT PERFORM THE SURVEY. I AM ONLY PLACING ON RECORD THE DATA.

C) Was the corner restored through acceptance of (1) an obliterated evidence location, or, (2) a found perpetuated location?

DID NOT ACCEPT NOR REJECT THE PROVIDED DATA.

- D) Describe any material discrepancy between the location of the corner as restored or reestablished and the location of that corner as previously restored or reestablished by distance and direction. Show the discrepancy on the plan view drawing under (a), above. Show the distances between the corner as previously restored or reestablished and (1) the corner as restored or reestablished, and (2) to at least 4 of the witness monuments shown on the drawing in (a), above.
 - (E) Was the corner reestablished through lost corner proportionate methods? If so, show the method, including the directions and distances to other public land survey corners used as evidence or used for proportioning the corner location.
 - I, Donald Barnes, hereby certify that the corner location as identified by the corner code index was determined by me under by direction and control and that this U.S. Public Land Survey Monument Record is correct and complete to the best of my knowledge and belief.

seal paines mals paines 7/25/1996

Number of included sheets __

CORNER CODE

A-E 7.08 REQUIREMENT