

U.S. PUBLIC LAND SURVEY MONUMENT RECORD

For Public Land Survey Corners in the


T. 2 N., R. 10 E.

CORNER CODE INDEX

1	2	3	4	5	6	7	8	9	10	11	12	13	14	15	16	17	18	19	20	21	22	23	24	25
A																								
B	6																							
C		5																						
D			4																					
E				3																				
F					2																			
G	7																							
H		6																						
I			5																					
J				4																				
K					3																			
L	8																							
M		7																						
N			6																					
O				5																				
P					4																			
Q	9																							
R		8																						
S			7																					
T	30																							
U		29																						
V			28																					
W				27																				
X					26																			
Y	31																							
Z		32																						
			33																					
				34																				
					35																			
						36																		

PLACE MONUMENT SYMBOL (◆) AT PROPER LOCATION ON ABOVE INDEX

EXAMPLE

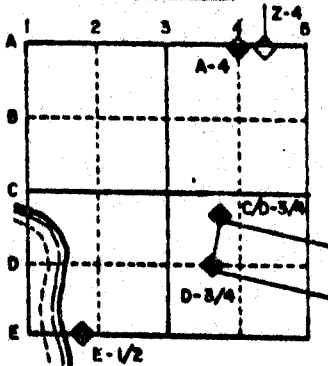

SPRING VALLEY TWP
ROCK COUNTY WI

IF AVAILABLE STATE PLANE COORDINATES

North (Y) _____ Eleve. (Z) _____
 East (X) _____ Zone _____
 Hor. Datum _____ Vert. Datum _____

a.) ◆ CORNER MONUMENT

○ WITNESS MONUMENT

See OTHER SIDE

BEARINGS ARE BASED ON:

MICROFILMED

SHEET ___ OF ___

CORNER CODE: A13

(B) Describe any record evidence, monument evidence, occupational evidence, testimonial evidence or any other material evidence you considered, and whether the monument was found or placed.

1834 MILLER INTERSECTED NORTH BOUNDARY 68.64 WEST OF POST. SET POST CORNER OF SECTIONS 3 & 4. BURR OAK 14 S57E 64.02, BUR OAK 12 S21W 50.82'

1861 RUGER VOL 1 PG 150 STATES NOTHING ABOUT THE CORNER BUT SHOWS 2669.04 TO THE N 1/4 CORNER OF SECTION 3 AND 2375.34 TO THE W 1/4 CORNER OF SECTION 3. ALSO SHOWS THAT THE N 1/4 CORNER OF SECTION 3 IS ON A STRAIGHT LINE BETWEEN THE NW AND NE CORNERS OF SECTION 3.

1867 LOCKE VOL 1 PG 288 FOUND STUMPS OF BTS & OLD STAKE. SET STAKE SURROUNDED BY 4 FLAT LIMESTONES. SHOWS EAST 68.64 TO THE SE CORNER OF SECTION 33. SHOWS 2381.28 TO THE E 1/4 CORNER OF SECTION 4.

1874 RUGER VOL 2 PG 133 FOUND STAKE SURROUNDED BY STONES. ALSO FOUND STUMP OF SW BT & WHERE STUMP OF SE BT HAD BEEN DUG UP. SHOWS EAST 68.64 TO SE CORNER OF SECTION 33.

19?? BATTERMAN JR. VOL 4 PG 213 STATES THAT HE DID NOT DIG. HE STATES THAT HE DUG AND FOUND NOTHING AT THE SW CORNER OF SECTION 34.

1973 LEE VOL 5 PG 3 SHOWS THE CORNER AND REFERENCED IT BUT STATES NOTHING ABOUT IT.

1973 LEE CSM VOL 3 PG 212. USED CORNER FOR SURVEY.

FOUND ALUMINUM MONUMENT. DUG AND FOUND 3 FLAT LIMESTONES AT SE CORNER OF SECTION 33.

C) Was the corner restored through acceptance of (1) an obliterated evidence location, or, (2) a found perpetuated location?


PLACED CORNER ON LINE WITH SE CORNER OF SECTION 33 AND S 1/4 CORNER OF SECTION 33 AT RECORD DISTANCE (68.64'). THIS IS IN HARMONY WITH RECORD DISTANCES.

D) Describe any material discrepancy between the location of the corner as restored or reestablished and the location of that corner as previously restored or reestablished by distance and direction. Show the discrepancy on the plan view drawing under (a), above. Show the distances between the corner as previously restored or reestablished and (1) the corner as restored or reestablished, and (2) to at least 4 of the witness monuments shown on the drawing in (a), above.

DID NOT ACCEPT FOUND ALUMINUM MONUMENT AS SHOWN IN DRAWING.

(E) Was the corner reestablished through lost corner proportionate methods? If so, show the method, including the directions and distances to other public land survey corners used as evidence or used for proportioning the corner location.

I, Donald Barnes, hereby certify that the corner points as identified by the corner code index were, in a field survey on, September 21, 1990, established, re-established, monumented, re-monumented, recovered or restored as expressed below and in conformance with the regulations and rules as required in the current manual of survey instructions of the United States Department of Interior, Bureau of Land Management.

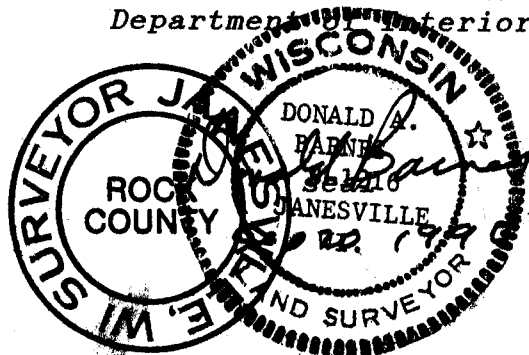

AFFIX YOUR LAND SURVEYOR SEAL


COUNTY SURVEYOR FILING DATA

Date of computer entry _____

Date microfilmed _____

Number of included sheets 1
CORNER CODE

A13

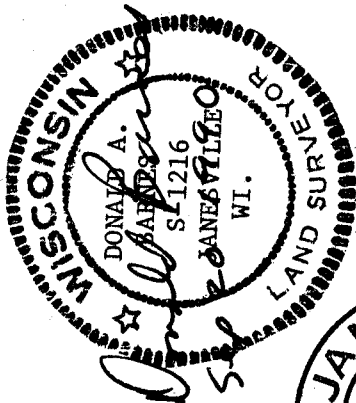


KNUTSON RD

XXXXXXXXXXXXXXXXXXXX
XXXXXXXXXXXXXXXXXXXX
XXXXXXXXXXXXXXXXXXXX
18

SE COR
SEC 33
FD STONES

TOWNLINE RD

NE SEC 4

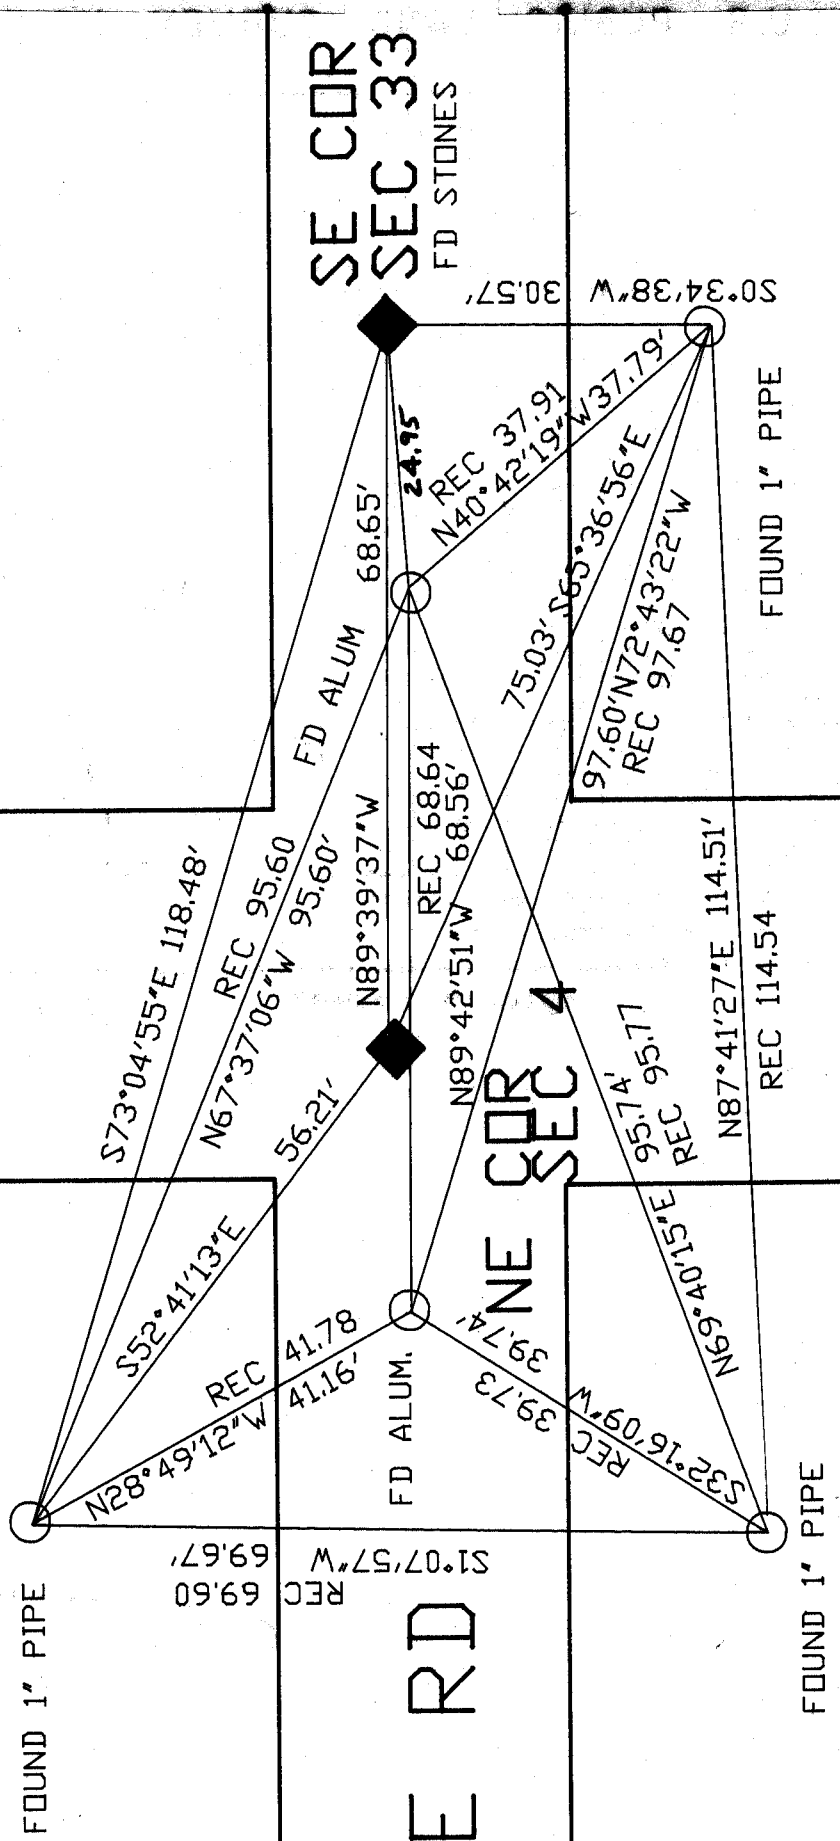

FIELD BOOK #3 PG 33