

U.S. PUBLIC LAND SURVEY MONUMENT RECORD


For Public Land Survey Corners in the

T. 2 N., R. 10 E.

CORNER CODE INDEX

	1	2	3	4	5	6	7	8	9	10	11	12	13	14	15	16	17	18	19	20	21	22	23	24	25
A																									
B																									
C	6																								
D		5																							
E			4																						
F				3																					
G					2																				
H	7																								
I		8																							
J			9																						
K				10																					
L					11																				
M						12																			
N							13																		
O								14																	
P									15																
Q										16															
R											17														
S												18													
T													19												
U														20											
V															21										
W																22									
X																	23								
Y																		24							
Z																			25						
																				26					
																					27				
																						28			
																							29		
																								30	
																									31
																									32
																									33
																									34
																									35
																									36

EXAMPLE

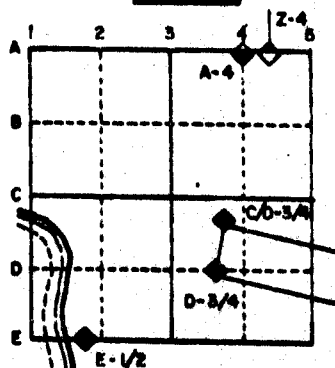

SPRING VALLEY TWP
ROCK COUNTY WI

IF AVAILABLE
 STATE PLANE COORDINATES

North (Y) _____ Eleve. (Z) _____
 East (X) _____ Zone _____
 Hor. Datum _____ Vert. Datum _____

PLACE MONUMENT SYMBOL (◆) AT PROPER
 LOCATION ON ABOVE INDEX

(a.) ◆ CORNER MONUMENT ○ WITNESS MONUMENT

BEARINGS ARE BASED ON:



MICROFILMED


SHEET _____ OF _____

CORNER CODE: A-17

FIELD SURVEY NOTES
PRESERVATION OF LANDMARKS
(Pursuant to Section 59.635(7) Wisconsin Statutes)


State Highway Commission of Wisconsin
Form E-D-707-85

COUNTY <i>Rock</i>		
TOWN <i>Spring Valley</i>		
HIGHWAY <i>STH 213</i>		
SECTION <i>2</i>	TOWNSHIP <i>2N</i>	RANGE <i>10E</i>
TYPE OF LANDMARK <i>1" Iron Pipe</i>		

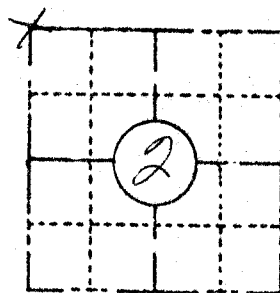

LOCATION SKETCH
(Location of landmark indicated by "x")

This space for copy of field notes or ties to the above described landmarks

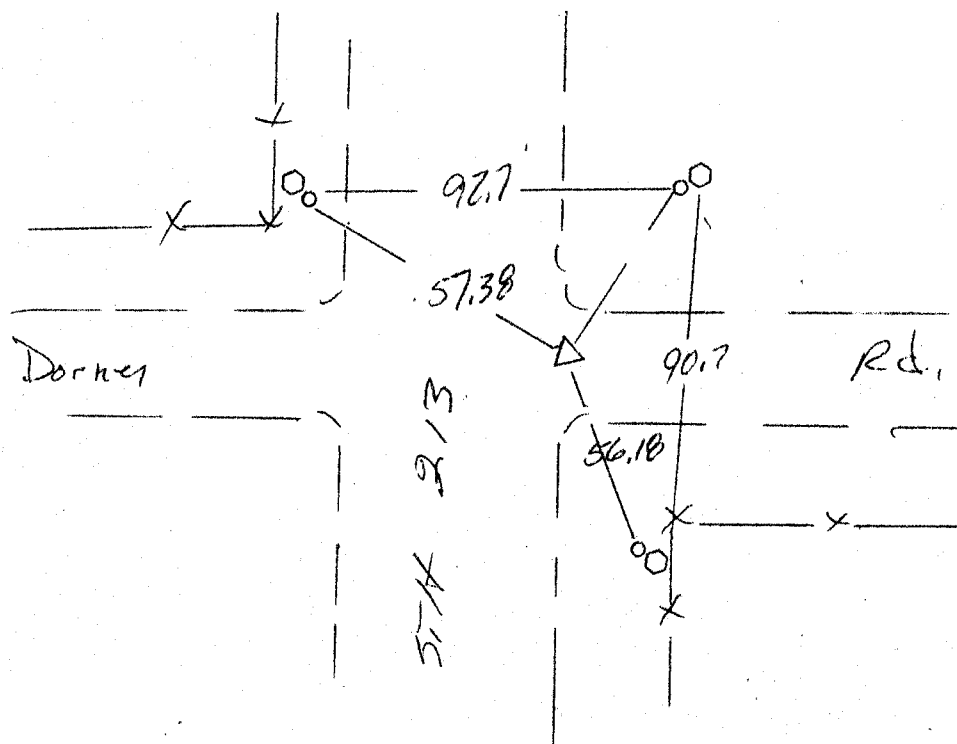

- = REFERENCE MONUMENT
- = RIGHT OF WAY POST
- ⬡ = WITNESS POST
- △ = SECTION CORNER LOCATION

COUNTY CLERK'S OFFICE	
COUNTY OF _____	WISCONSIN } 85
DATE RECEIVED FOR RECORD	DATE COPY SENT TO COUNTY SURVEYOR <i>8/25</i>
SIGNATURE OF COUNTY CLERK	

PRESERVATION OF LANDMARKS

PAGE _____