
U.S. PUBLIC LAND SURVEY MONUMENT RECORD

For Public Land Survey Corners in:

WI ADMINISTRATIVE CODE A-E 7.08 REQUIREMENT

T. ZN., R. 10 E

CORNER CODE INDEX

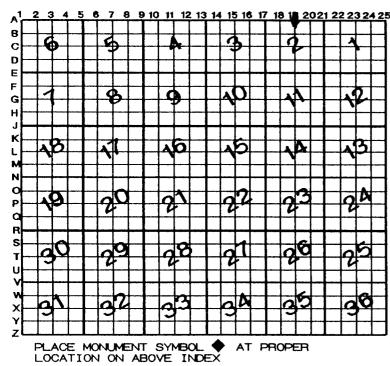

SPRING Valley TWP
ROCK COUNTY WI

IF AVAILABLE ROCK COUNTY COORDINATES PERFERRED

North Elev
East
Hor. Datum Vert. Datum
LATITUDEELLIPS. HT.
LONGITUTE
GPS (X) TRAVERSE (X)
BASED ON THE FOLLOWING CONTROL:

♦CORNER MONUMENT

O WITNESS MONUMENT

BEARINGS ARE BASED ON:

(a)

				,		
				j		7
FIELD BOOK	PAGE #		SHEET	c)F	2
SHOW A PLAN VIEW	DRAWING DEPICTING THE CORNER MONUMENT	F AND	SURRO	UNDING		
PHYSICAL FEATURES.	. INCLUDING THE EXCAVATION AREA AND DEP	TH.				

PLANNING & ZONING COMMITTEE ADOPTED THE ABOVE FORM ON 12/2/1982

SP510

(B)Describe any record evidence, monument evidence, occupational evidence, testimonial evidence or any other material evidence you considered, and whether the monument was found or placed.

CORNER WAS NOT ESTABLISHED BY THE ORIGINAL SURVEY. NO OTHER RECORD OF CORNER.

PLACED 3/4X24 REROD MIDWAY & ON LINE WITH NW & NE CORNERS OF SEC 2.

- C) Was the corner restored through acceptance of (1) an obliterated evidence location, or, (2) a found perpetuated location?
- D) Describe any material discrepancy between the location of the corner as restored or reestablished and the location of that corner as previously restored or reestablished by distance and direction. Show the discrepancy on the plan view drawing under (a), above. Show the distances between the corner as previously restored or reestablished and (1) the corner as restored or reestablished, and (2) to at least 4 of the witness monuments shown on the drawing in (a), above.
- (E) Was the corner reestablished through lost corner proportionate methods? If so, show the method, including the directions and distances to other public land survey corners used as evidence or used for proportioning the corner location.

SINCE THE CORNER WAS NOT ESTABLISHED, I ESTABLISHED IT ACCORDING TO THE RULES FOR A LOST CORNER.

I, Donald Barnes, hereby certify that the corner location as identified by the corner code index was determined by me under my direction and control and that this U.S. Public Land Survey Monument Record is correct and complete to the best of my knowledge and belief.

Donald Baines
April 21, (998

Number of included sheets __

CORNER CODE

A-19

A-E 7.08 REQUIREMENT

