U.S.

(a)

ÿ O

ARE

BEARINGS


PUBLIC LAND SUR MONUMENT RECORD

For Public Land Survey Corners in:

WI ADMINISTRATIVE CODE A-E 7.08 REQUIREMENT

T.2 N., R. 10 E

CORNER CODE INDEX

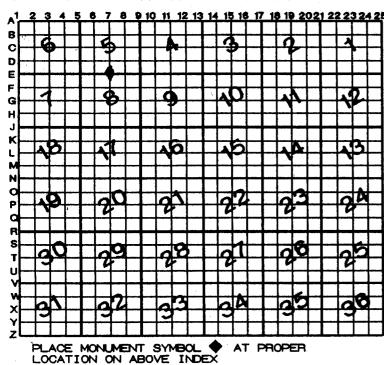

SPRING VALLEY TWP

IF AVAILABLE
ROCK COUNTY COORDINATES PERFERRED

North _____ Elev. ____

East _____

Hor. Datum ____ Vert. Datum __

LATITUDE _____ELLIPS. HT.

LONGITUTE

GPS (X) __ TRAVERSE (X) _

BASED ON THE FOLLOWING CONTROL:

◆CORNER MONUMENT

O WITNESS MONUMENT

FARM FIELD FARM FIELD *N 1/4 COR* SEC 8 19.88 S88-00-00E % 22-H XXXXXXXXXXXXX *XXXXXXXXXXXXXXXXXXXXXXXXXXXXXXXX* 3/4X24 REROD FD G-1 MONUMENT FD CUT LIMESTONE PLACED CARSONITE POST WOODS **OBSERVATION SHEET #524** WOODS

FIELD BOOK _____PAGE # _____ OF _____ SHEET ____ OF ____ SHOW A PLAN VIEW DRAWING DEPICTING THE CORNER MONUMENT AND SURROUNDING PHYSICAL FEATURES, INCLUDING THE EXCAVATION AREA AND DEPTH.

PLANNING & ZONING COMMITTEE ADOPTED THE ABOVE FORM ON 12/2/1982

CORNER CODE

E2

sp524

(B) Describe any record evidence, monument evidence, occupational evidence, testimonial evidence or any other material evidence you considered, and whether the monument was found or placed.

1855 CHURCH VOL 1 PG 42 STATES NOTHING ABOUT MONUMENT. CALLS FOR 5280'

TO S 1/4 COR SEC 8, 2640 TO CENTER OF SEC 8.

1866 LOCKE VOL 1 PG 257 FOUND B.T.s & STAKE. SET STAKE & SURROUNDED IT BY 3 HH, SUBDIVIDED SEC 8 BY EQUAL DISTANCE METHOD. PLACED STAKE EVERY 1321.32' ALONG N/S 1/4 LINE. CALLS FOR VAR 8-45 2642.64 TO CENTER OF SEC 8, & VAR 6-35 2642.64 FROM CENTER TO S 1/4 COR SEC

1879 RUGER VOL 2 PG 263 FD B.T.s WITNESS TREES ALSO STAKE & STONES SET BY LOCKE. SET IN THE PLACE OF THEM A L.S. 26X9X6 SURROUNDED BY 3 STONES. CALLS FOR VAR 5-00 2660.46' TO NE COR SEC 8, VAR 5-32 2654.52' TO NW COR SEC 8, VAR 6-42 2646.27 TO CENTER OF SEC 8. ESTABLISHED CENTER OF SEC 8 BY EQUAL DISTANCE METHOD.

1964 BATTERMAN JR. VOL 4 PG 191 FOUND LIMESTONE. CALLS FOR STONE SOUTH

OF E/W FENCE & WEST OF N/S FENCE.

1978 BARNES VOL 5 PG 490

1978 BARNES VOL 5 PG 488 FOUND CUT LIMESTONE AT T FENCE INTERSECTION. REFERENCED SAME.

FOUND CUT LIMESTONE & 2 REFERENCE MONUMENTS. REFERENCED LIMESTONE AND PLACED CARSONITE POST NEXT TO MONUMENT.

- Was the corner restored through acceptance of (1) an obliterated evidence location, or, (2) a found perpetuated location? ACCEPTED FOUND PERPETUATED LOCATION.
- Describe any material discrepancy between the location of the corner as restored or reestablished and the location of that corner as previously restored or reestablished by distance and direction. Show the discrepancy on the plan view drawing under (a), above. Show the distances between the corner as previously restored or reestablished and (1) the corner as restored or reestablished, and (2) to at least 4 of the witness monuments shown on the drawing in (a), above.
- Was the corner reestablished through lost corner proportionate methods? If so, show the method, including the directions and distances to other public land survey corners used as evidence or used for proportioning the corner location.
- I, Donald Barnes, hereby certify that the corner location as identified by the corner code index was determined by me under my direction and control and that this U.S. Public Land Survey Monument Record is correct and complete to the best of my knowledge and belief.

Dec 6, 1996

Number of included sheets

CORNER CODE