
U.S. PUBLIC LAND SURVEY MONUMENT RECORD

For Public Land Survey Corners In:

WI ADMINISTRATIVE CODE A-E 7.08 REQUIREMENT

T. 2N. R. 11 E.

CORNER CODE INDEX

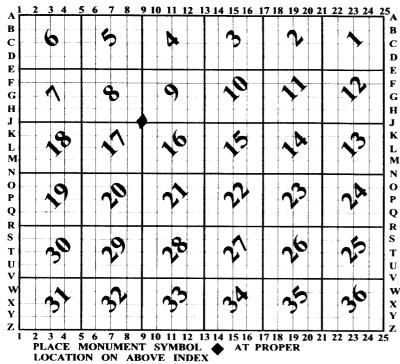

PLYMOUTH TWI

IF AVAILABLE ROCK COUNTY COORDINATES PERFERRED

North	Elev.
East	
Hor. Datum	Vert. Datum
LATITUDE _	ELLIPS. HT
LONGITUDE	
GPS (X)	TRAVERSE (X)
BASED ON TH	E FOLLOWING CONTROL:

♦ CORNER MONUMENT

O WITNESS MONUMENT

BEARINGS ARE BASED ON:

(a)

FIELD BOOK _____ PAGE # ____ OF SHOW A PLAN VIEW DRAWING DEPICTING THE CORNER MONUMENT AND SURROUNDING PHYSICAL FEATURES, INCLUDING THE EXCAVATION AREA AND DEPTH.
PLANNING & ZONING COMMITTEE ADOPTED THE ABOVE FORM ON 12/2/1982

PT.545 (B) Describe any record evidence, monument evidence, occupational evidence, testimonial evidence or any other material evidence you considered, and whether the monument was found or placed. 1833 HARRISON NORTH BET 16 & 17 2640 QUARTER SEC COR IN MARSH POST & RAISED MOUND

BROOK 6.6' CRS S.E. 4158 4587 LEFT MARSH & ENTER TIM.

5280 COR TO SECS B, 9,16,17 (W.O. 24 N39E 128.04' W.O. 36 N19W 118.80' BURR O 24 S71W 235.62' BURR 0 18 55E 100.32' LAND MOSTLY LEVEL & WET 3RD RATE MARSH.

EAST ON RAND. BET 9 & 16

LEFT TIMBER & ENTER MARSH 1980

2640 TEMPY 1/4 P

5082 LEFT MASH & ENTER TIMBER

5294.52 INT. E BDY 27.72' N OF P LEVEL & WET 2ND RATE TIMBER ? BURR O

COR. WEST

2647.26 QUARTER SEC COR IN MARSH POST & MOUND OF TUSSACH

5294.52 SEC COR

NORTH BET. SECS 8 & 9

361.02 W.O 24

2640 QUARTER SEC COR. (BURR O 16 561E 55.44' BURR O 19 580W 44.22' BURR O 16 BURR O 19 MARKED

4620 LEFT TIMBER & ENTERED MARSH

5280 COR TO SECS 4 5 8 9 {RED D. 16 532W 502.92' LAND ROLLING 2ND RATE WITH ? RED & W.D. TIMBER ? & GRASS

EAST BET 8 & 17 ON RAND

2640 TEMPY 1/4 P

3234 LEFT MARSH & ENTER TIM

INT. E BDY 12.54' N OF P LEVEL 1 ST 1/2 MILE SAME 5291.88 LAST 1/2 ROLLING 2 RATE WITH BURR O TIMBER COR WEST

2645.94 QUARTER SEC COR (BURR O 12 514E 373.56' BURR 0 20 55E 395.34' BURR 0 12 BURR 0 10 MARKED

5291.88 SEC COR

1858 CHURCH VOL 1 PG 76 VR 6 2624.16 TO S 1/4 COR SEC 8 1965 LOCKE VOL 1 PG 228 FD E B.T. & STUMP OF W. BT & OLD STAKE. W. BT IS 2.30 CH (151.8') INSTEAD OF 1.80 (118.8') VAR 6-25 2655.84 TO N ¼ COR SEC 16 & VAR 6-15 TO E ¼ COR SEC 17

- 1962 CHURCH TWP RD REC BK 1 PG 43 COMMENCING AT THE SEC COR BETWEEN SEC 9 & 10 ON THE NORTH LINE OF SAID SECTIONS AND RUNNING THENCE SOUTH ON SEC LINE TO SOUTH LINE OF SAID SEC; THENCE WEST ON SEC LINE TO THE SW COR OF SEC 8.
- 1867 TWP RD REC BK 1 PG 54 COMMENCING AT THE SE COR OF SEC 8 AND RUNNING NORTH ON THE SECTION LINE BETWEEN SEC 8 & 9 TO THE NE COR OF SEC 8 THENCE IN A NORTHERLY DIRECTION TO A PT 33' EAST OF THE SE COR OF THE NE 1/4 OF THE SE 1/4 OF SEC 5 THENCE NORTH ON THE EAST SIDE OF THE SECTION LINE BETWEEN SECTIONS 4 7 5 TO THE QUARTER POST ON SAID SEC. LINE, OR TO INTERSECT WITH RD RUNNING SOUTH FROM FOOTVILLE. THE LINE OF SAID SURVEY TO BE THE CENTER OF SAID HWY, AND THE SAME IS ESTABLISHED 66' IN WIDTH.

1868 LOCKE VOL 1 PG 320 & MAP #4335 FD E B.T. & STUMP OF W. BT & OLD STAKE. VAR 7-36 2651.88 TO W 1/4 COR SEC 9. 1868 LOCKE PG 57 SOUTH BETWEEN SECS 8 AND 9 VAR 6-45

2656.83 INTERSECTED 1/4 LINE .33' WEST OF COR.

FOUND STUMPS OF BTS AND COR AS SET BY SHEET 1 OF 3 CORNER CODE J-9

Pend Baines May 12,2003

SELF. (SEE CO S RECORD) COR. IN LINE OF FENCE RUNNING SOUTH.

CONTINUED SOUTH FROM 1/4 COR WITH VAR 7-30

3983.1 1/16 COR SET BY SELF (SEE CO S RECORD)
5309.37 INTERSECTED SOUTH BOUNDARY AT COR.
FOUND BTS IN SECS 9 AND 16 AND STUMPS
OF BTS IN SECS B AND 17 AND STAKE. COR

IS EAST PAST OF A "PAIR OF BURRS" IN E AND W FENCE.

PG 58 EAST BETWEEN SECS 9 AND 16 VAR 6-20

1328.58 1/16TH COR SET BY SELF.

2661.12 INTERSECTED ¼ LINE 6.6' NORTH OF COR.
FOUND COR. AS SET BY SELF IN COR. OF SOD
FENCE RUNNING S AND W. (SEE COUNTY
SURVEYOR RECORD) VAR CORRECTED 6-11
CONTINUED EAST FROM ¼ COR WITH VAR 5.

5325.54 INTERSECTED EAST BOUNDARY AT COR. SEP 5 1868

1868 LOCKE PG 83 EAST BETWEEN SECS 8 AND 17 VAR 6-15

BET DFF 46.86' SOUTH

1369.5 FENCE RUNNING NORTH

2661.12 INTERSECTED 1/4 LINE AT COR. FOUND B.TS EAST BT IS \$16E AND WEST BT IS 395.34' DIST. COR 2.97' SOUTH OF E & W FENCE AND 26.07' WEST OF FENCE RUNNING NORTH AND NEAR THE END OF A SOD FENCE RUNNING WEST VAR CORRECTED 5-14

5313.33 INTERSECTED EAST BOUNDARY 11.22' NORTH OF COR. VAR CORRECTED 6-20 SEPT 16. 1868 PG 84 NORTH BETWEEN SECS 16 & 17 VAR 7-32

2457.18 CENTER OF RR TRACK

2640 SET TEMPORARY ¼ COR COR LOST.

3488.1 CENTER OF BROOK 7.92' WIDE

3656.4 CENTER OF BROOK 7.92' WIDE

5311.02INTERSECTED NORTH BOUNDARY AT COR.

2655.51 SET ¼ COR 15.51' NORTH OF TEMPORARY ¼ COR SURROUNDED MONUMENT WITH STAKES AND MOUND SEPT 16, 1868

1869 RUGER VOL 2 PG 10 STONE MON BY LOCKE 2645.94 TO 5
'4 COR SEC 8

1873 RUGER VOL 2 PG 121 STONE MON. VAR 5-45 2645.61 TO N
1/4 COR SEC 17 & 2648.25 TO E 1/4 COR SEC 17

1974 LEE VOL 5 PG 9 PREVIOUSLY DUG & FD NOTHING.

1978 BARNES VOL 5 PG 501 N89-22-55W 2652.79 TO N ¼ COR SEC 17, S89-31-09E 2661.71 TO N ¼ COR SEC 16, S0-29-12E 2656.44 TO E ¼ COR SEC 17, NO-33-14W 2652.80 TO E ¼ COR SEC 8

1978 BARNES VOL 5 PG 504 THE FORMER COUNTY SURVEYOR DUG & FD NOTHING. THE CORNER WAS ESTABLISHED AT THE PRORATED DISTANCES FROM THE E ¼ CORNER, OF SEC 8, THE E ¼ COR OF SEC 17, THE SW COR OF SEC 8, AND THE S ¼ COR OF SEC 9. THE DISTANCES WERE PRORATED WITH LOCKE'S 1868 REMONUMENTATION DISTANCES. THIS LOCATION IS ALSO IN HARMONY WITH EMMETT MURPHY'S STATEMENT "IN THE EARLY 1930S, I LIVED AT THE FARM ADJACENT TO THE SECTION CORNER AND REMEMBER THE HIGHWAY DEPARTMENT REMOVING THE STONE DURING ROAD CONSTRUCTION, AS I RECALL THE STONE WAS ON LINE WITH THE FENCE TO TE EAST & ON THE EAST SIDE OF THE ROAD. SET ALUM. MON & REFERENCED SAME.

1997 SROEDER CSM VOL 20 PG 328 STATES NOTHING ABOUT MON.

1998 COMBS CSM VOL 21 PG 416 ALUM MON. 2652.92 TO E $\frac{1}{4}$ COR SEC 8

SHEET 2 OF 3 CORNER CODE J-9

final Barnes May 12 2003 PL545

1999 KREBS VOL 6 PG 455 SO-00-36W 2656.24 TO E 1/4 COR SEC 17 & 2652.74 TO N 1/4 COR SEC 17.

2000 BARNES VOL 6 PG 455 NB9-22-55W 2652.79 TO N $\frac{1}{4}$ COR SEC 17, SB9-31-11E 2661.70 TO N $\frac{1}{4}$ COR SEC 16, ND-33-15W 2652.79 TO E $\frac{1}{4}$ COR SEC B, & SO-29-14E 2656.44 TO E $\frac{1}{4}$ COR SEC 17.

FD ALUM, MON, 0.5' DEEP & 6' EAST OF CENTER OF PVMT & ON LINE WITH E/W FENCE. FD REF. TIES.

C) Was the corner restored through acceptance of (1) an obliterated evidence location, or, (2) a found perpetuated location?

ACCEPTED FD. ALUM. MON.

- D) Describe any material discrepancy between the location of the corner as restored or reestablished and the location of that corner as previously restored or reestablished by distance and direction. Show the discrepancy on the plan view drawing under (a), above. Show the distances between the corner as previously restored or reestablished and (1) the corner as restored or reestablished, and (2) to at least 4 of the witness monuments shown on the drawing in (a), above.
- (E) Was the corner reestablished through lost corner proportionate methods? If so, show the method, including the directions and distances to other public land survey corners used as evidence or used for proportioning the corner location.

I, Donald Barnes, hereby certify that the corner location as identified by the corner code index was determined by me under my direction and control and that this U.S. Public Land Survey Monument Record is correct and complete to the best of my knowledge and belief.

Donald Barres May 12 2003

Eudosa

SHEET 3 OF 3