U.S.


PUBLIC LAND SURVEY MONUMENT RECORD

For Public Land Survey Corners in:

WI ADMINISTRATIVE CODE A-E 7.08 REQUIREMENT

、T. <u>2</u> N., R. <u>//</u>E

CORNER CODE INDEX

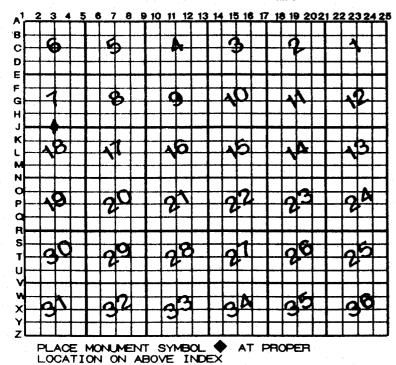

PLYMOUTH TWE ROCK COUNTY WI

IF AVAILABLE
ROCK COUNTY COORDINATES PERFERRED

North _____ Elev. ____

East _____

Hor. Datum ____ Vert. Datum ____

LATITUDE ____ ELLIPS. HT.

LONGITUTE ____ ERLIPS. HT.

GPS (X) ___ TRAVERSE (X) ___

BASED ON THE FOLLOWING CONTROL:

♦CORNER MONUMENT

WITNESS MONUMENT

BEARINGS ARE BASED ON:

(a)

						41	2
FIELD	BOOK	PAGE #			SHEET	3 OF	
				ORNER MONUM	ENT AND SURRO	UNDING	
PHYSIC	AL FEATURES.	INCLUDING THE	EXCAVATIO	N AREA AND D	DEPTH.		

PLANNING & ZONING COMMITTEE ADOPTED THE ABOVE FORM ON 12/2/1982

PL542

(B) Describe any record evidence, monument evidence, occupational evidence, testimonial evidence or any other material evidence you considered, and whether the monument was found or placed.

1833 HARRISON WEST ON RAND. BET 7 & 18

2640 TEMPY 1/4 P

5314.98 INT. W. BDY 148.5' N OF P. LAND WET & LEVEL 3RD RATE MARSH

COR EAST

2674.98 QUARTER SEC COR. POST & SMALL MOUND OF TUSSUCKS

5314.98 SEC COR

- 1857 CHURCH VOL 1 PG 66 VAR 7 2687.52 TO SW COR SEC 7, VAR 7 2659.80 TO SE COR SEC 7, VAR 7-45 2637.36 TO CENTER SEC 7, & VAR 7-45 5274.72 TO N 1/4 COR SEC 7.
- 1857 CHURCH VOL 1 PG 67 & MAP #3527 STAKE & STONE IN MARSH. VAR 7 ½ 2704.68 TO CENTER SEC 18 & 5409.36 TO S ¼ COR SEC 18.
- 1868 LOCKE PG 82 EAST BETWEEN SECS 7 AND 18 VAR 7-52 2640 SET TEMPORARY 1/4 COR
 - 5345.34 INTERSECTED EAST BOUNDARY 86.46' SOUTH OF COR. COR LOST SEE PAGE 77 VAR CORRECTED 8-48
 - 2690.16 SET ¼ COR 50.16' EAST AND 43.23' NORTH OF TEMPORARY COR. SURROUNDED MONUMENT BY PLANK PILES. SEP 16 1868
- 1868 LEE VOL 1 PG 335 & MAP #3526 FD FLAG POLE SET AT COR BY LOCKE IN PLYMOUTH SURVEY ALSO FD (CHUCKS) SET BY HIM. VAR 6-30 2638.02 TO CENTER SEC 18 & 5327.52 TO S 1/4 COR SEC 18.
- 1869 RUGER VOL 2 PG 9 STONE MON. SET BY LOCKE VAR 8-40 2687.52 TO SW COR SEC 7, VAR 8-40 2657.16 TO SE COR SEC 7, VAR 6-14 2645.94 TO CENTER SEC 7, & VAR 6-14 5404.74 TO N 1/4 COR SEC 7.
- 1914 KERCH VOL 5 PG 578 FB K6 PG 80 FD MON.
- 1979 BARNES VOL 5 PG 561 2643.69 TO CENTER SEC 18 & 5323.6 TO S 1/4 SEC 18.
- 1979 BARNES VOL 6 PG 1 N86-01-35W 2691.22 TO SW COR SEC 7 & S86-01-35E 2657.23 TO SE COR SEC 7
- 1979 BARNES VOL 6 PG 7 DUG & FD NOTHING. THE COR. WAS PROBABLY DESTROYED BY DITCHING. SET ALUM. MON. ON LINE WITH THE NW & NE CORNERS & SINGLE PROPORTIONATE MEASUREMENT WITH LOCK'S DISTANCES. NORTH OF E/W DRAINAGE DITCH & WEST OF N/S DRAINAGE DITCH.
- 1989 BARNES VOL 6 PG 402 REC DISTANCES. 5405.54 TO N 1/4 COR SEC 7.

MONUMENT WAS DESTROYED BY DIGGING THE DITCH.

C) Was the corner restored through acceptance of (1) an obliterated evidence location, or, (2) a found perpetuated location?

USED MY OLD OBSERVATIONS. DID NOT PLACE ANYTHING AT THE BOTTOM OF THE DITCH.

I, **Donald Barnes**, hereby certify that the corner location as identified by the corner code index was determined by me under my direction and control and that this U.S. Public Land Survey Monument Record is correct and complete to the best of my knowledge and belief.

reliba

Emboss

SHEET 1 OF 2

4-07-03

corner code J-3

A.E. 7.08 REQUIREMENT

