
# PUBLIC LAND MONUMENT RECORD

For Public Land Survey Corners In:

WI ADMINISTRATIVE CODE A-E 7.08 REQUIREMENT

T. 2N. R. 1/E.

CODE INDEX CORNER

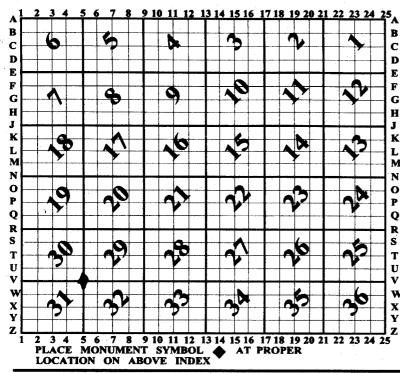

PLYMOUTH TWP **ROCK COUNTY WI** 

IF AVAILABLE ROCK COUNTY COORDINATES PERFERRED

North Elev. East Hor. Datum \_\_\_\_\_ Vert. Datum **LATITUDE** ELLIPS. HT. LONGITUDE

GPS (X) TRAVERSE (X) BASED ON THE FOLLOWING CONTROL:

**CORNER MONUMENT** 

**WITNESS MONUMENT** 

BEARINGS ARE BASED ON:

(a)

BSFRUATION	SHEET	24Z
------------	-------	-----

FIELD BOOK SHEET PAGE # SHOW A PLAN VIEW DRAWING DEPICTING THE CORNER MONUMENT AND SURROUNDING PHYSICAL FEATURES, INCLUDING THE EXCAVATION AREA AND DEPTH. PLANNING & ZONING COMMITTEE ADOPTED THE ABOVE FORM ON 12/2/1982

of 3

### PL603

(B) Describe any record evidence, monument evidence, occupational evidence, testimonial evidence or any other material evidence you considered, and whether the monument was found or placed.

1833 HARRISON DEC. PG 32 NORTH BETWEEN SEC 31 & 32

QUARTER SEC COR NEAR N.E. EDGE OF PRAIRIE BUR OAK 24 586E 378.84'

4785 LEFT PRAIRIE & ENTER TIMBER

5280 COR TO SECS 29,30,31,32 BUR OAK 24 N41E 51.48', BUR OAK 18 N22W 97.02', BUR OAK

EAST ON RAND. BET 29 & 32

2640 TEMPY 1/4 P

2838 LEFT TIMBER & ENTERED PRAIRIE

5285.94 INT. E BDY 6.6'S OF P LAND WEST ½ ? 2<sup>ND</sup> RATE WITH RED & W.O TIMBER E ½ ROLLING 1<sup>ST</sup> RATE PRAIRIE

COR. WEST

2642.97 QUARTER SEC COR. {BLK D 24 N26E 27.06' BLK D. 12 S23E 26.4' BLK D 24 BLK D 12} MARKED

5285.94 SEC COR

WEST BET 30 & 31

165 LEFT TIM. & ENTER PRAIRIE

2145 LEFT PRAIRIE & ENTER TIM.

2640 TEMPY 1/4 P

3234 BROOK 3.3' CRS SW

5297.16 INT. W. BDY AT P & ESTABLISHED COR TO SECS 30 & 31 BEARINGS {W.O. 14 NB5W 99' W.O. 24 S73E 119.46' LAND ROLLING 1<sup>ST</sup> RATE WITH LYNN ASPEN HICKY, WALNUT, BURR & W.O.

COR EAST

2657.16 QUARTER SEC COR {RED 0 20 N23E 23.1' ASPEN 16 S5E 9.9'

5297.16 SEC COR

NORTH BET SECS 29 & 30

1326.6 LEFT TIMBER & ENTER PRAIRIE

2640 QUARTER SEC COR ON GROUND ASCENDING N. SET POST & RAISED MOUND.

5280 SEC COR TO SECS 19, 20, 29, 30 SET POST & RAISED MOUND. LAND HIGH ROLLING 1<sup>ST</sup> RATE PRAIRIE GROWTH GRASS & WEEDS.

1844 PEASE TWP RD RECORDS BK 1 PG 4 COMMENCING AT THE CORNERS OF SEC 26,27,34 AND 35, IN T2N R11E AND RUNNING WEST ON THE LINE BETWEEN SECTIONS 27 & 34, 2622.84'. SET POST WHERE OLD 1/4 POST ON SAID LINE STOOD BURNT STUMP OF WHITE DAK BEARS N5W 13.86' AND SBBE 73.92'; THENCE WEST ON SAID LINE 2622.84' TO THE CORNER OF SEC 27,28,33, & 34, SET POST WHITE OAK 24 INCHES IN DIA BEARS \$35E 114.18', BURNT STUMP OF BASS WOOD 24" N7BE 86.46"; THENCE WEST ON LINE BETWEEN SECS 28 AND 33 TO CORNER OF SEC 28,29,32 & 33 5224.5' SETING POST IN OLD MOUND; THENCE WEST ON LINE BETWEEN SECTIONS 29 & 32, 2652.8' SET POST BY BLACK DAK 24 INCH BEARS N26E 27.06'; THENCE WEST ON THE LINE BEFORE SAID 2642.64' TO THE COR OF SEC 29,30,31 & 32, BLACK CAK BEARS N41E 78? AND N22W 97.02'; THENCE WEST OF LINE BETWEEN SEC 30 & 31, 5297.16' TO THE LINE BETWEEN RANGES 10 & 11 EAST 4 MILES AND 5.94'. SAID RD EXTENDS 33' ON EACH SIDE OF THE ABOVE LINE.

1868 LOCKE PG 61 WEST BETWEEN SEC 29 AND 32 VAR 6-

2659.8 INTERSECTED 1/4 LINE 4.62' SOUTH OF COR.
FOUND REMAINS OF NORTH BT AND LIMESTONE
ABOVE OLD STAKE IN CENTER OF HIGHWAY AND IN
LINE OF FENCE RUNNING NORTH VAR CORRECTED
6. CONTINUED WEST FROM 1/4 COR WITH VAR 6

2904 SET OFF 7.92' NORTH

3379.2 CENTER OF SLUICE BRIDGE

SHEET 1 OF 3 CORNER CODE V-5

Finald Barnes 1/03/03

## PL603

2244

2508

SET OFF 6.27' NORTH 4026

SET OFF 8.58' NORTH 5016

5314.98 INTERSECTED WEST BOUNDARY AT COR. FOUND B.T.S IN SEC 31 AND 32 AND STUMP OF BT IN 29 AND STONE ON COR. COR IN CENTER OF HIGHWAY. VAR CORRECTED 5-30 SEP 9 1868

PG 62 NORTH BETWEEN SECS 29 AND 30 VAR 7-10

OFF 19.14' п

1327.92 FENCE RUNNING EAST

2652.54 INTERSECTED 1/4 LINE 13.53' WEST OF COR. FOUND LARGE LIMESTONE SET FOR COR. 4 INCHES WEST OF FENCE POST AT ANGLE OF ROAD AND ON SOUTH SIDE THERE OF. VAR CORRECTED 7-17

CONTINUED NORTH FROM 1/4 COR WITH VAR 7-10

5304.75 INTERSECTED NORTH BOUNDARY 3.63' EAST OF COR. FOUND STAKE SET BY SELF. (SEE CO. SURVEYOR RECORD) SEC 20) VAR CORRECTED 7-15 SEPT 9 1868 PG 63 WEST BETWEEN SECS 30 AND 31 VAR 7-20

SET OFF 14.52' NORTH BET OFF 36.96' NORTH

2641.98 INTERSECTED 1/4 LINE 3.3' SOUTH OF COR. FOUND NORTH BT AND WHERE SOUTH B.T. WAS DUG OUT AND LARGE LIMESTONE ON COR. IN HIGHWAY AND IN LINE WITH FENCE RUNNING SOUTH. VAR

CORRECTED 6-09

SET OFF 6.6' NORTH OF 1/4 COR & CONTINUED WEST WITH VAR 7-08

CENTER OF BRIDGE 9.24' WIDE 3158.1

3532.32 CENTER OF SLUICE BRIDGE

SET OFF 5.28' NORTH 4422

INTERSECTED WEST BOUNDARY 22.77' SOUTH OF 5311.02 COR. FOUND B.T.S IN SECS 30 AND 31 AND 35 AND 36 AND OLD STAKE VAR CORRECTED IS 6-23 BT IN 31 IS 667E BT IN 25 IS 96.36' & BT IN 36 IS 126.72' SETP 10, 1868

PG 71 NORTH BETWEEN SECS 31 & 32 VAR 7-10

INTERSECTED 1/4 LINE 11.22' WEST OF 1/4 COR. 2676.3 FOUND STUMP OF B.T. AND OLD STAKE COR. IN N AND S FENCE. VAR CORRECTED 6-55 CONTINUED NORTH FROM 1/4 COR WITH VAR 7-5

INTERSECTED NORTH BOUNDARY 18.48' EAST OF COR. VAR CORRECTED 7-29 SEPT 12 1868

1869 LEE VOL 2 PG 5 FD MON. VAR 7-20 2655.18 TO E1/4 COR SEC 30 & 2645.28 TO 5 1/4 COR SEC 30

1875 RUGER VOL 2 PG 193 STONE MON. VAR 4-30 2651.88 TO N  $\frac{1}{4}$  COR SEC 32 & VAR 6-13 2650.56 TO W  $\frac{1}{4}$  COR SEC 32.

1958 BATTERMAN VOL 3 PG 528 FD 6X6X36" CUT STONE. A FOOT OF TOP BROKE OFF. 1' DEEP. REF. SAME.

1978 BARNES VOL 5 PG 428 FD R/R SPIKE. TERRIAN INDICATES RD GUT. SET ALUM & REF SAME. PK 2.92' TO THE WEST & PK 3.05' TO THE SOUTH, FD 2 REC REF. PIPES.

1992 KREBS CSM15-512 CUT L.S.

1992 KREBS CSM VOL 15 PG 512 FD ALUM

1993 KREBS MAP #09824 CUT L.S. EAST 2654.41 TO N 1/4 COR SEC 32 & S2-01-06E 2652.10 TO W 1/4 COR SEC 32.

1999 TALARCZKE MAP #08048 CAST ALUM. WEST 2642.10 TO N 4 COR SEC 31 651-26-10E 2651.97 TO E 4 COR SEC 31.

And Barnes 1/03/03

# **LFEG3**

FD ALUM. MON. & REF. MONUMENTS.

C) Was the corner restored through acceptance of (1) an obliterated evidence location, or, (2) a found perpetuated location?

ACCEPTED FD ALUM. MON, WHICH PERPETUATED CUT L.S. LOCATION.

- D) Describe any material discrepancy between the location of the corner as restored or reestablished and the location of that corner as previously restored or reestablished by distance and direction. Show the discrepancy on the plan view drawing under (a), above. Show the distances between the corner as previously restored or reestablished and (1) the corner as restored or reestablished, and (2) to at least 4 of the witness monuments shown on the drawing in (a), above.
- (E) Was the corner reestablished through lost corner proportionate methods? If so, show the method, including the directions and distances to other public land survey corners used as evidence or used for proportioning the corner location.

I, Donald Barnes, hereby certify that the corner location as identified by the corner code index was determined by me under my direction and control and that this U.S. Public Land Survey Monument Record is correct and complete to the best of my knowledge and belief.

Depol Barres 1/03/03 Emboss

SHEET 3 OF 3

CORNER CODE V-5

A.E. 7.08 REQUIREMENT