Paper	weigh	 iir	n1mum)


LAND U.S. **PUBLIC** SURVEY MONUMENT RECORD

For Public Land Survey Corners in:

WI ADMINISTRATIVE CODE A-E 7.08 REQUIREMENT

T. 2N., R. \_\_//\_E

CORNER CODE INDEX

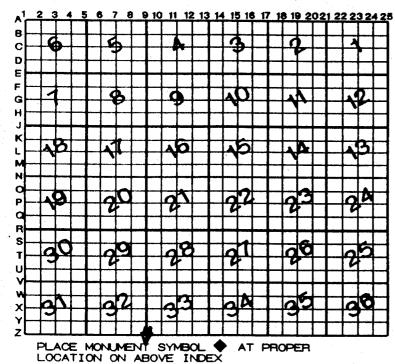

PLY WOUTHTWP

ROCK COUNTY WI

IF AVAILABLE ROCK COUNTY COORDINATES PERFERRED

North Elev. East

Hor. Datum \_\_\_\_\_ Vert. Datum

LATITUDE \_ ELLIPS. HT. LONGITUTE

GPS (X) \_\_\_ TRAVERSE (X) \_\_\_ BASED ON THE FOLLOWING CONTROL:

**♦**CORNER MONUMENT

O WITNESS MONUMENT

BEAFINGS ARE BASED ON

(a)

OBSERVATION	N SHEETS	A 25, 4	505,7704	
FIELD BOOK	PAGE #	<u></u>		SHEET
SHOW A PLAN VIEW	DRAWING DEPICTING	THE CORNER	MONUMENT AND	SURRO
	, INCLUDING THE EXC			

PLANNING & ZONING COMMITTEE ADOPTED THE ABOVE FORM ON 12/2/1982

corner code 2-9

## SE32 PL625

(B)Describe any record evidence, monument evidence, occupational evidence, testimonial evidence or any

other material eviden	ce you considered, and whether the monument was found or placed.
	WEST ON SOUTH SIDE SECTION 33
2640	SET QUARTER SECTION POST IN PRAIRIE AND MOUND OF
	EARTH AND SODS
3102	INDIAN PATH CS S.E.
5280	SET POST CORNER SECTIONS 32 & 33 MADE A MOUND OF
	EARTH AND SODS LAND ROLLING SECOND RATE DRY PRAIRIE
	WEST ON SOUTH SIDE SECTION 32 (2N R11E)
66	LEAVE PRAIRIE AND ENTER MARSH
330	STREAM 2.64' C SOUTH
759	LEAVE MARSH AND ENTER WOOD LAND
1188	ENTER PRAIRIE
2640	SET QUARTER SECTION POST IN PRAIRIE SECTION POST IN
	PRAIRIE AND MADE A MOUND
5280	SET POST CORNER SECTION 31 & 32 IN PRAIRIE AND MADE
	MOUND LAND MOST ROLLING DRY PRAIRIE FIRST RATE BY
	OBSERVATION VAR FOUND 7-35
1833 HARRISO	N NORTH BETWEEN SEC 32 & 33 (T2NR11E)
1320	ROAD CRS N.W.
2640	QUARTER SEC COR IN PRAIRIE ON GROUND DESCENDING
	S.E. SET POST & RAISED MOUND.
5280	COR TO SECS 28,29,32,33 IN A RAVINE CRS S.E. SET A POST
	& RAISED MOUND. LAND HIGH ? 1ST RATE PRAIRIE
1834 MILLER	NORTH BETWEEN SEC 4 & 5
264	ENTER CREEK BOTTOM
1683	BROOK 6.6' S,W, BOTTOM MARSH
1980	LEAVE SAME (BOTTOM)
2640	SET 1/4 SEC POST. BUR OAK 14 IN S4E 54.78'; BUR OAK
	12 IN N49W 58.0B'
3630	BUR DA 14
	ENTER PRAIRIE
	BROOK 3.3' S.E.
5267.46	INTERSECT NORTH BOUNDARY 36.96 EAST OF POST SET
	POST IN MOUND OF EARTH AND SOD COR OF SEC 4 & 5.
	LAND ROLLING 2ND RATE DAK & HICKORY TIMBER. MARCH
	11, 1834
1868 LOCKE F	PLYMOUTH TWP REMONUMENTATION SEP 11 1868
and the <u>a</u> nd the state	PG 70 WEST ON SOUTH LINE SEC 32 VAR 6-20
	SET OFF 12.87' SOUTH ER OF BRIDGE OVER CREEK 7.92'
	CENTER OF BRIDGE OVER CREEK 7.92'
	SET TEMPORARY 1/4 COR. COR. LOST INTERSECTED WEST BOUNDARY 60.39' SOUTH OF COR.
5321.91	FOUND OLD STAKE & WHERE B.T.S WERE DUG OUT. COR. IN
	CENTER OF HIGHWAY RUNNING SOUTH & ON SOUTH SIDE OF
	E & W HIGHWAY
000000	SET 1/4 COR 20.96' WEST AND 36.63' NORTH OF
2660.96	TEMPORARY 1/4 COR VAR CORRECTED (WHOLE LINE) 5-49
	IEMPURART 1/4 GUR VAR GURREGIED (WHOLE LINE) 5-49

SEPT 11 1868

WEST ON SOUTH LINE SEC 33 VAR 6-20 PG 69

CENTER SLUICE BRIDGE 4.62' WIDE 1214.4

1712.04 CENTER SLUICE BRIDGE 3.96' WIDE

INTERSECTED 1/4 LINE AT COR. FOUND OLD STAKE IN 2668.71 CENTER OF HIGHWAY AND IN LINE WITH FENCE RUNNING NORTH. SURROUNDED MONUMENT BY HEAP OF LIMESTONE. CONTINUED WEST WITH VAR 6-20

2705.34 CENTER OF SOUTH END OF BRIDGE

SHEET 1 OF 3 CORNER CODE Z-9

Janold Banes 3-07-03

9 INTERSECTED WES \_\_DARY 12.87' SOUTH VAR CORRECTED 6-04. 1/4 MONUMENT MARKED 33 ON ITS NORTH FACE.

PG 68 SOUTH BETWEEN SECS 32 AND 33 VAR 7-15

SEPT 11, 1868

SET OFF 10.89' EAST

- 2661.12 INTERSECTED 1/4 LINE 10.89' EAST OF COR. FOUND MOUND AT JUNCTION OF FENCES ON WEST SIDE OF HIGHWAY AND IN LINE OF E & W FENCES. VAR CORRECTED 7-15 CONTINUED SOUTH FROM 1/4 COR WITH VAR 7-15
- 5320.59 INTERSECTED SOUTH BOUNDARY 3.96' EAST OF COR. FOUND LARGE LIMESTONE ON COR. UNDERNEATH INDICATIONS OF STAKE. COR IN CENTER OF E & W HIGHWAY AND NEARLY IN LINE OF FENCE ON WEST SIDE OF HIGHWAY RUNNING NORTH. VAR CORRECTED 7-10 PG 212 EAST ON NORTH LINE OF 4 VARIATION 5-40

5334.12 SECTION COR.

BACK TO

2667.06 SET 1/4 STONE 31.02' EAST OF PLYMOUTH 1/4 COR. NOV 6,1871 1871 COLLIN REMONUMENTATION NEWARK TWP TIN R11E

NORTH BETWEEN 4 & 5 VARIATION 6-30

2570.04 SET STONE FOR 1/4 COR BY STUMPS OF WITNESS TREES WITH VARIATION OF NEEDLE REVERSED.

CONTINUED NORTH VARIATION 7-30

5109.72 SET STONE FOR CORNER OF 4 & 5 36.96' EAST OF PLYMOUTH CORNER NOV 2 1871

EAST ON NORTH LINE OF 5 VARIATION 5-43

5386.92 SET STONE FOR CORNER OF 4 & 5 36.96' EAST OF PLYMOUTH CORNER

BACK

SET 1/4 STONE 5.94' EAST OF PLYMOUTH 1/4 COR. 2693.46 PG 212 EAST ON NORTH LINE OF 4 VARIATION 5-40

5334.12 SECTION CORNER

BACK TO

2667.06 SET 1/4 STONE 31.02' EAST OF PLYMOUTH 1/4 CORNER. NOV 6, 1871

- 1871 RUGER VOL 2 PG 75 STONE MON. @ SW COR SEC 33. 2655.84 VAR 6-20 TO W 1/4 COR SEC 33, 2665.41' VAR 5-20 TO S 1/4 COR SEC 33.
- 1875 RUGER VOL 2 PG 193 STONE MON. VAR 6-20 TO E 1/4 COR SEC 32
- 1878 RUGER VOL 2 PG 244 FD STONE MON. VAR 4-30 2688.18 NE 5TO N 1/4 COR SEC 5. VAR 7-05 2534.4 TO E 1/4 COR SEC 5.
- 1957 BATTERMAN VOL 3 PG 521 STONE MON. NOT FD 2640.72 NW 4 TO S 1/4 COR SEC 33, AT SE COR SEC 32 DUG 15X15X4 1/2 DEEP & FD NOTHING.
- 1967 BATTERMAN VOL 4 PG 312 FD CUT L.S. AT BOTH CORNERS. REFERENCED SAME. 36.93 BETWEEN CORNERS. PLYMOUTH IS WEST OF NEWARK.
- 1976 BARNES VOL 5 PG 172 FD FLAGGED CARPENTERS NAIL. 2.5' DEEP FD CUT STONE. SET BERNTSEN & REFERENCED SAME.
- 1978 BARNES VOL 5 PG 473 S88-47-39E 2667.29 NW 4 TO N 1/4 COR SEC 4, S88-23-24E 36.79 TO NEWARK CORNER, NO-04-39E 2661.98 FROM SE COR TO E 1/4 COR SEC 32 PLYMOUTH TWP, & 2673.85 FROM SE TO S 1/4 COR SEC 33 PLYMOUTH TWP.
- 1978 BARNES VOL 5 PG 430 2651' FROM ALUM MON NEAR SE COR SEC 32 TO SOUTH EDGE OF EXCAVATION @ E 1/4 COR SEC 32.
- 1980 LEUENBURGER CSM10-143 36.8 EAST TO NW COR SEC 4 NEWARK TWP 1993 KREBS MAP #09824 ALUM. 36.77 WESTERLY OF NE COR SEC 5 NEWARK TWP, S89-44-31W 2662.95 TO S 1/4 COR SEC 32, N1-38-35E 2661.98 TO E 1/4 COR SEC 32.
- 2001 BARNES A-9 FD ALUM AT NE COR SEC 5. MON IS EAST OF PVMT EDGE & 4.5' N OF CENTER OF PVMT. FD TIES OF RECORD VOL 5 PG 172

FD BERNTSEN MON. & TIES

SHEET 2 OF 3 CORNER CODE Z-9

Dinald Burnes 3-07-03

C) Was the corner restored through acceptance of (1) an obliterated evidence location, or, (2) a found perpetuated location?

ACCEPTED FD BERNTSEN MON, WHICH PERPETUATED CUT L.S.

- D) Describe any material discrepancy between the location of the corner as restored or reestablished and the location of that corner as previously restored or reestablished by distance and direction. Show the discrepancy on the plan view drawing under (a), above. Show the distances between the corner as previously restored or reestablished and (1) the corner as restored or reestablished, and (2) to at least 4 of the witness monuments shown on the drawing in (a), above.
- (E) Was the corner reestablished through lost corner proportionate methods? If so, show the method, including the directions and distances to other public land survey corners used as evidence or used for proportioning the corner location.
- I, **Donald Barnes**, hereby certify that the corner location as identified by the corner code index was determined by me under my direction and control and that this U.S. Public Land Survey Monument Record is correct and complete to the best of my knowledge and belief.

Seal Banes 3-07-03

SHEET 3 OF 3

CORNER CODE Z-9

A-E 7.08 REQUIREMENT