

U.S. PUBLIC LAND SURVEY MONUMENT RECORD

For Public Land Survey Corners in the


T. ___ N., R. ___ E.

CORNER CODE INDEX

	1	2	3	4	5	6	7	8	9	10	11	12	13	14	15	16	17	18	19	20	21	22	23	24	25
A																									
B																									
C	6																								
D																									
E																									
F																									
G																									
H	7																								
I																									
J																									
K																									
L	8																								
M																									
N																									
O																									
P	9																								
Q																									
R																									
S																									
T	30																								
U																									
V																									
W																									
X	31																								
Y																									
Z																									

PLACE MONUMENT SYMBOL (◆) AT PROPER LOCATION ON ABOVE INDEX

EXAMPLE

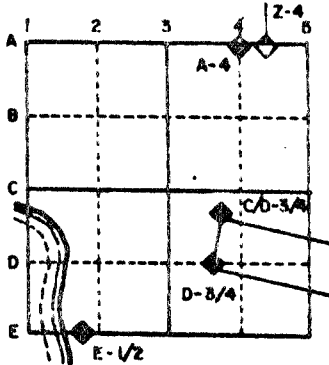

_____ TWP
ROCK COUNTY WY

IF AVAILABLE
STATE PLANE COORDINATES

North (Y) _____ Eleve. (Z) _____
 East (X) _____ Zone _____
 Hor. Datum _____ Vert. Datum _____

◆ CORNER MONUMENT

○ WITNESS MONUMENT

BEARINGS ARE BASED ON:

MICROFILMED

SHEET ___ OF ___

CORNER CODE:

Rock
La Prairie


HIGHWAY Avalon Rd.

SECTION NO. 17 - center 1/4 corner

T. 2 N., R. 13 E.


TYPE OF LANDMARK Limestone 16"x3"x3" Sq.

LOCATION INDICATED ON SKETCH X

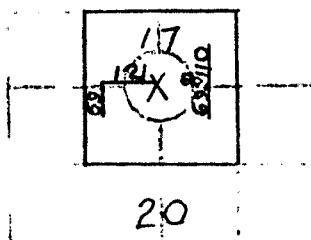

LOCATION SKETCH

After extensive field search, a limestone rock, as described above, was uncovered approximately 1' below asphalt.

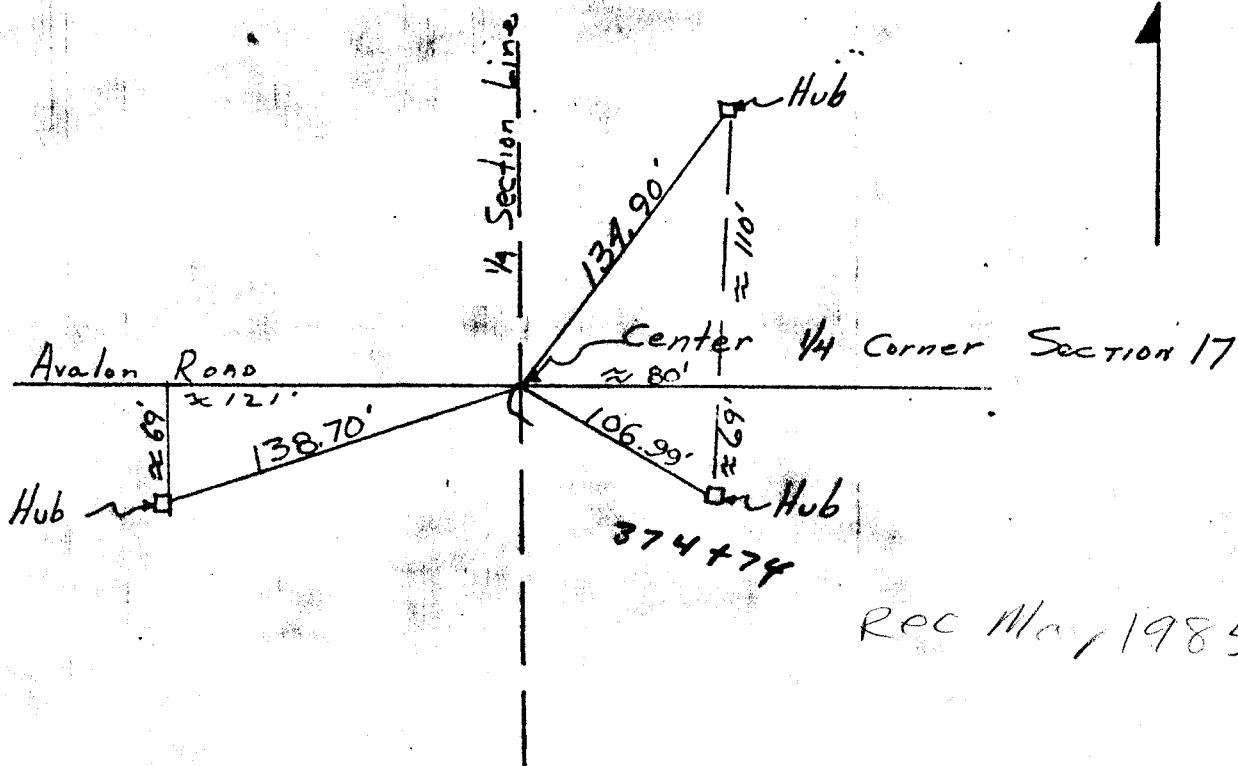

This space for copy of field notes or tie to the above description
in book no. NOTES 7-3-58 TH.R. pp(2)

TOWNSHIP JANESVILLE

ROCK Rock

DATE T.H. RICHARD

7-3-58

L-7