

# U.S. PUBLIC LAND SURVEY MONUMENT RECORD

For Public Land Survey Corners in the


T. \_\_\_ N., R. \_\_\_ E.

## CORNER CODE INDEX

	1	2	3	4	5	6	7	8	9	10	11	12	13	14	15	16	17	18	19	20	21	22	23	24	25
A																									
B																									
C	6																								
D																									
E																									
F																									
G																									
H	7																								
I																									
J																									
K																									
L	18																								
M																									
N																									
O																									
P	19	20	21	22	23	24																			
Q																									
R																									
S																									
T	30	29	28	27	26	25																			
U																									
V																									
W																									
X	31	32	33	34	35	36																			
Y																									
Z																									

PLACE MONUMENT SYMBOL (◆) AT PROPER LOCATION ON ABOVE INDEX

### EXAMPLE

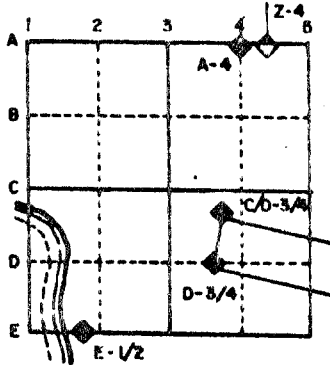

\_\_\_\_\_ TWP  
ROCK COUNTY WI

IF AVAILABLE  
STATE PLANE COORDINATES

North (Y) \_\_\_\_\_ Eleve. (Z) \_\_\_\_\_  
 East (X) \_\_\_\_\_ Zone \_\_\_\_\_  
 Hor. Datum \_\_\_\_\_ Vert. Datum \_\_\_\_\_

e.)

◆ CORNER MONUMENT

○ WITNESS MONUMENT

BEARINGS ARE BASED ON:


MICROFILMED

SHEET \_\_\_ OF \_\_\_


CORNER CODE: \_\_\_\_\_

K Hennings 2  
266-6900

Rock  
LAPRAIRIE  
NONE  
S. 1/4 Cor. Sec. 17  
2 R. 13  
6" x 6" limestone

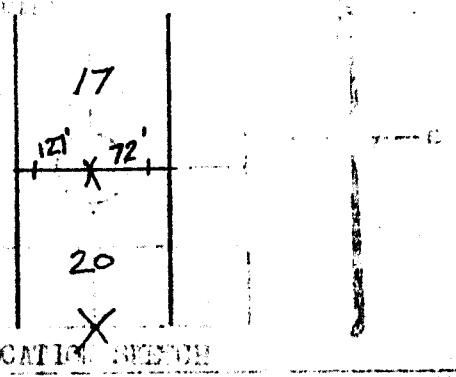

Located near a fence corner approximately 0.3 ft above surface.

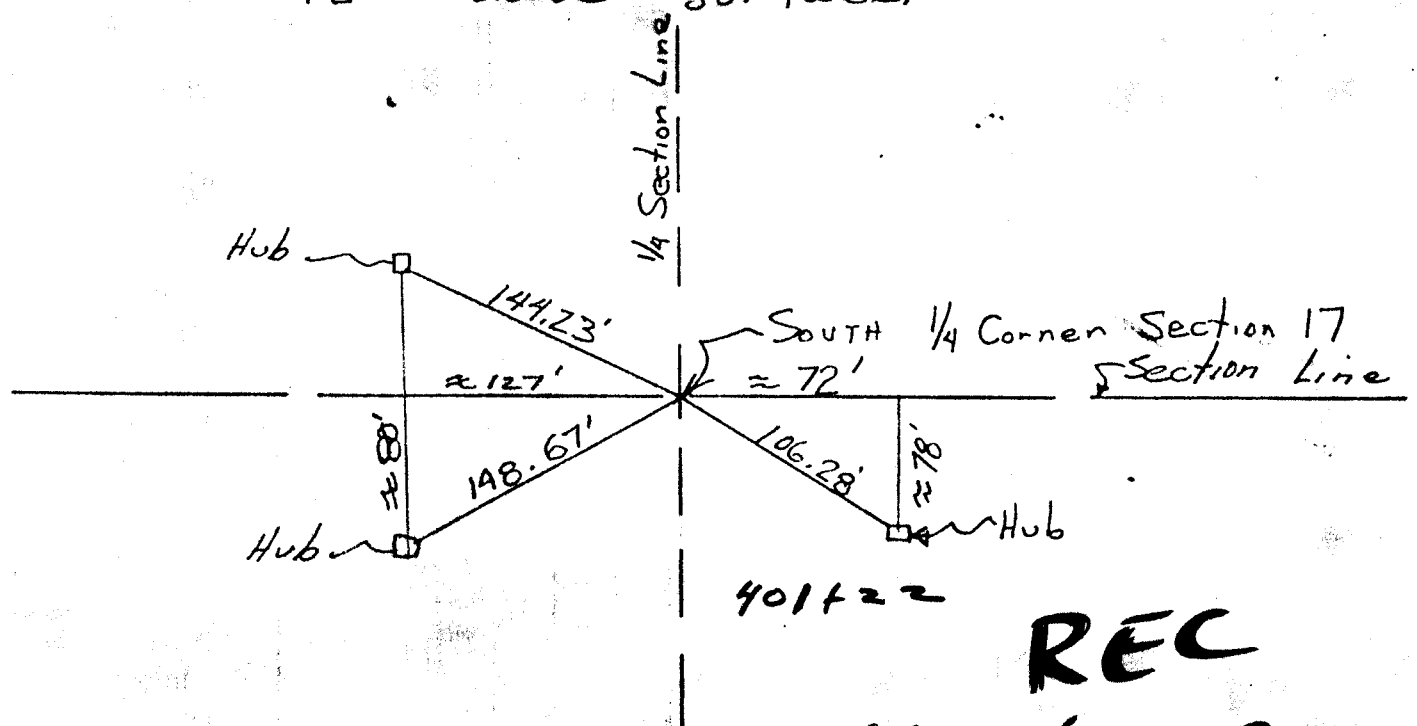

REC  
May 6 1985

This space for copy of field notes or ties to the above described landmark.

Field notes or records filed in book no. NOTES pp 3  
 of Janesville Rock.  
 recorded by T.H. RICHARD 7-3-58

EGH

N7