required


U.S. PUBLIC LAND SURVEY MONUMENT RECORD

For Public Land Survey Corners in:

WI ADMINISTRATIVE CODE A-E 7.08 REQUIREMENT

TAN., R. 12 E

CORNER CODE INDEX

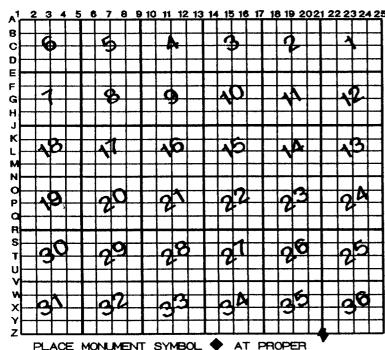

FULTON		TWP
ROCK	COUNTY	WI

IF AVAILABLE ROCK COUNTY COORDINATES PERFERRED

North ______ Elev. ____

East _____

Hor. Datum _____ Vert. Datum _____

LATITUDE _____ ELLIPS. HT.

LONGITUTE _____ ERLIPS. HT.

GPS (X) ____ TRAVERSE (X) ___

BASED ON THE FOLLOWING CONTROL:

♦ CORNER MONUMENT

LOCATION ON ABOVE INDEX

WITNESS MONUMENT

BEARINGS ARE BASED ON:

(a)

FIELD BOOK _____PAGE # _____ SHEET ____ OF ____SHOW A PLAN VIEW DRAWING DEPICTING THE CORNER MONUMENT AND SURROUNDING PHYSICAL FEATURES, INCLUDING THE EXCAVATION AREA AND DEPTH.
PLANNING & ZONING COMMITTEE ADOPTED THE ABOVE FORM ON 12/2/1982

JA511

- (B)Describe any record evidence, monument evidence, occupational evidence, testimonial evidence or any other material evidence you considered, and whether the monument was found or placed.
- 1836 MULLETT VAR 8-20 EAST WEST ON SOUTH SIDE SECTION 36 SET POST COR SECTIONS 35 & 36 BURR OAK 10 N49W 2.05, BURR OAK N86E 14
- 1836 LYON ORIG NORTH BETWEEN SECTIONS 1 & 2
 INTERSECTED NORTH BOUNDARY 26.4' EAST OF POST SET COR TO SECTIONS 1
 & 2. BUR OAK 18 S82 1/2E 37, BUR OAK 12 S16W 71
- 1870 RUGER VOL 2 PG 20 CALLS FOR NE COR 26.4' EAST OF SE COR SEC 35. 2658.48 VAR 7-10 TO N 1/4 COR SEC 2. N 1/4 COR SEC 2 IS MIDWAY & ON LINE WITH NE & NW CORNERS OF SEC 2.
- 1872 LEE VOL 2 PG 93 AT NE COR SEC 2 SET HH 10X6X4. 1.98' WEST OF SLUICE LOG IN RD. FD STUMP OF EAST B.T. SHOWS NE COR SEC 2 AS EAST OF SE COR SEC 35. VAR 6-50 2623.50' TO N 1/4 COR SEC 1. N 1/4 COR SEC 1 IS MIDWAY & ON LINE BETWEEN NE & NW CORNERS OF SEC 1.
- 1875 RUGER VOL 2 PG 190 BLACK OAK TREE 7" IN DIAMETER MARKED WITH 3 HACKS ON EACH SIDE OF THE 4 SIDES. SEE BK 2 PG 1 & 3. 2641.76' VAR 5-48 TO W 1/4 COR SEC 36.
- 1875 RUGER VOL 2 PG 188 FD WHERE STUMPS OF B.T.S TO COR FOR FULTON HAD BEEN DUG UP. THE COR FOR FULTON HAD BEEN DUG UP. THE COR FOR FULTON IS 26.4' WEST OF COR FOR JANESVILLE. BL. OAK TREE 7" IN DIA AT COR FOR FULTON. MARKED SAID TREE BY CUTTING 3 HACKS ON EACH OF THE 4 SIDES. 2641.76' VAR 5-48 TO E 1/4 COR SEC 35.
- 1939 SUNNY VOL 3 PG 446 SE COR SEC 35 SET 2"X4" C.I. ROUND MON. IN CONC. PVMT. NORTH CORNER OF SEC 1 & 2 JANESVILLE TWP SET 2X36 IRON PIPE MON FOR COR. REFERENCED BOTH CORNERS. 2612.3 FROM NW COR SEC 1 TO FENCE AT N 1/4 COR SEC 1. SHOWS SE COR SEC 35 NEAR WEST EDGE OF PVMT. 2646.2 FROM SE COR SEC 35 TO E 1/4 COR SEC 35. 2914.1 FROM NE COR SEC 2 TO E 1/4 COR SEC 2.
- 1965 BATTERMAN JR. VOL 4 PG 220 FD BRASS PLUG AT SE COR SEC 35, FD PIPE AT NW COR SEC 1, & REFERENCED SAME. 26.41 BETWEEN MONUMENTS.
- 1977 BARNES VOL 5 PG 373 SE COR SEC 35 FD ROUND C.I. MON. & REFERENCED SAME. NE COR SEC 2 FD 1" PIPE IN MON. BOX IS 26.48" EAST OF CI.
- 1980 BARNES VOL 6 PG 17 COMPOSITE OF RECORD DISTANCES.
- 1982 LEUENBERGER VOL 6 PG 365 2647.21 FROM SE TO E 1/4 COR SEC 35.
- 1987 BARNES REMONUMENTATION. N89-03-32E 2619.62 FROM NW COR SEC TO N 1/4 COR SEC 1 & N88-54-12E 2619.46 FROM N 1/4 COR TO NE CORNERS OF SEC 1, S0-39-52E 2914.99 FROM NE TO E 1/4 COR OF SEC 2, & S89-09-52W 26.74 FROM NE COR SEC 2 TO SE COR SEC 35.
- 1987 COMBS VOL 6 PG 365 2662.821' FROM SE COR SEC 35 TO S 1/4 COR SEC 35 & N1-20-37W 2647.21 TO E 1/4 COR SEC 35.

FOUND PIPE IN MON. BOX AT THE NE COR OF SEC 2 JANESVILLE TWP. & ALUM. MON AT THE SE COR SEC 35 FULTON TWP.

C) Was the corner restored through acceptance of (1) an obliterated evidence location, or, (2) a found perpetuated location?

ACCEPTED FOUND MONUMENTS AS PERPETUATED LOCATION

Donald formers May 12, 1999

D) Describe any material discrepancy between the location of the corner as restored or reestablished and the location of that corner as previously restored or reestablished by distance and direction. Show the discrepancy on the plan view drawing under (a), above. Show the distances between the corner as previously restored or reestablished and (1) the corner as restored or reestablished, and (2) to at least 4 of the witness monuments shown on the drawing in (a), above. **NONE**

(E) Was the corner reestablished through lost corner proportionate methods? If so, show the method, including the directions and distances to other public land survey corners used as evidence or used for proportioning the

NO

I, Donald Barnes, hereby certify that the corner location as identified by the corner code index was determined by me under my direction and control and that this U.S. Public Land Survey Monument Record is correct and complete to the best of my knowledge and belief.

seal

Number of included sheets 1

ParaloBacnes emboss May 12,1999

CORNER CODE **Z-21**

