
## LAND SURVEY U.S. PUBLIC MONUMENT RECORD

For	Public	Land	Survey	Corners	In:
-----	--------	------	--------	---------	-----

WI ADMINISTRATIVE CODE A-E 7.08 REQUIREMENT

T. 2N. R. // E.

CORNER CODE INDEX

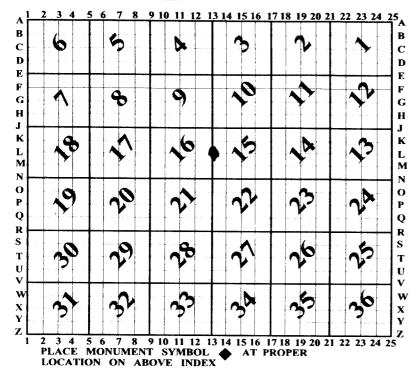

PLYMOUTH TWP **ROCK COUNTY WI** 

IF AVAILABLE ROCK COUNTY COORDINATES PERFERRED

Elev.

ELLIPS. HT.

East				
Hor.	Datum	Vert.	Datum	

LATITUDE

LONGITUDE \_\_

GPS (X) \_\_\_\_ TRAVERSE (X) \_ BASED ON THE FOLLOWING CONTROL:

CORNER	<b>MONUMENT</b>

O WITNESS MONUMENT

SEE TIES
FOR

BEARINGS ARE BASED ON:\_

(a)

OBSERVATION SHEETS, 269, 805 FIELD BOOK PAGE # SHEET SHOW A PLAN VIEW DRAWING DEPICTING THE CORNER MONUMENT AND SURROUNDING PHYSICAL FEATURES, INCLUDING THE EXCAVATION AREA AND DEPTH. PLANNING & ZONING COMMITTEE ADOPTED THE ABOVE FORM ON 12/2/1982

## PT.557

(B) Describe any record evidence, monument evidence, occupational evidence, testimonial evidence or any other material evidence you considered, and whether the monument was found or placed.

1833 HARRISON PG 22 NORTH BETWEEN 15 & 16

594 **BURR 0** 15

924 LEFT TIMBER & ENTER MARSH

2640 QUARTER SEC COR (BURR 0 16 N40W 201.3' BURR O 16 652E 216.48' BURR O 14 BURR O

16 MARKED

5016 LEFT MARSH & ENTER TIMBER

5280 COR TO SECS 9 10 15 16 (BURR 0 16 N10W 66' BURR O 24 535W 53.46' BURR O 12 N77E 19.8' BURR O S38E 158.4' LAND LEVEL & WET 3RD RATE MOSTLY MARSH

1847 TWP RD REC BK 1 PG 21 BEGINNING AT THE NW COR OF SEC 3 AND 4, 9 AND 10, 15 AND 16, 21 AND 22 TO THE SW COR OF SEC 22. SAID RD IS 66' IN WIDTH

1868 LOCKE PG44 NORTH BETWEEN SECS 15 & 16 VAR6-50

2640 SET TEMPORARY ¼ COR. CO. LOST

4185.72 CENTER OF M&M RR

4686 BASS CREEK

5305.41 INTERSECTED NORTH BOUNDARY AT COR.

2652.71 SET 1/4 COR 12.71' NORTH OF TEMPORARY 1/4 COR COR JUST EAST OF N & S FENCE SEPT 3 1868

1873 RUGER VOL 2 PG 112 FD STONE MON. VAR 6-54 2649.24 TO SW COR SEC 15, NORTHERLY VAR 6-15 1477.08 TO STAKE ON SOUTH SIDE OF RAIL ROAD, VAR 5-42 2620.86 TO CENTER OF SEC 15, & VAR 5-42 5238.42 TO E 1/4 COR SEC

1976 BARNES VOL 5 PG 155 FD CUT STONE MARKED S 1/4 AT GROUND LEVEL. REFERENCED SAME. MON @ FENCE CORNER.

1987 BARNES N-13 SO-51-53E 2654.10 TO SW COR SEC 15.

1987 COMBS CSM VOL12 PG 612 CUT L.S. ANGLE OF 88-47-35 @ SE COR SEC 16 FROM S 1/4 TO E 1/4 COR SEC 16

1990 SCHROEDER CSM VOL 14 PG 342 STATES NOTHING.

1998 COMBS MAP #8060 STONE MON. 2654.02 TO SW COR SEC 15

## FD CUT L.S. & TIES.

C) Was the corner restored through acceptance of (1) an obliterated evidence location, or, (2) a found perpetuated location?

## ACCEPTED FD CUT L.S.

- D) Describe any material discrepancy between the location of the corner as restored or reestablished and the location of that corner as previously restored or reestablished by distance and direction. Show the discrepancy on the plan view drawing under (a), above. Show the distances between the corner as previously restored or reestablished and (1) the corner as restored or reestablished, and (2) to at least 4 of the witness monuments shown on the drawing in (a), above.
- (E) Was the corner reestablished through lost corner proportionate methods? If so, show the method, including the directions and distances to other public land survey corners used as evidence or used for proportioning the corner location.
- I, Donald Barnes, hereby certify that the corner location as identified by the corner code index was determined by me under my direction and control and that this U.S. Public Land Survey Monument Record is correct and complete to the best of my knowledge and belief.

Kind Barres Emboss May 12 2003

SHEET 1 OF 1

CORNER CODE L-13