
U.S. PUBLIC LAND SURVEY MONUMENT RECORD

For Public Land Survey Corners in the For Miscellaneous Corners within Sec. T. 2 N., R. 11 E. CORNER CODE INDEX 2 3 4 Above code numbers are positioned Meander, Claim, or Fractional corners of the section. Township corner code numbers shall be applied to the corners of above typical section. EXAMPLE **⊹33** PLACE MONUMENT SYMBOL (4) AT PROPER LOCATION ON ABOVE INDEX IF AVAILABLE STATE PLANE COORDINATES North (Y) ____ Eleve. (Z) ·East (X) Hor. Datum Vert. Datum O WITNESS MONUMENT **CORNER MONUMENT** CENTER OF SEC 14

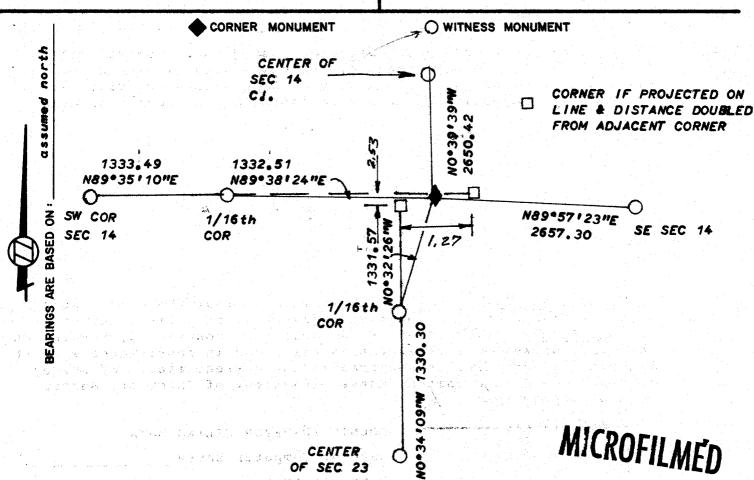

SHOW A PLAN VIEW DRAWING DEPICTING THE CORNER MONUMENT AND SURROUNDING PHYSICAL FEATURES, INCLUDING THE EXCAVATION AREA AND DEPTH. THE CORNER MONUMENT SHALL HAVE THE FOLLOWING CHARACTERISTICS: 1) HAVE AT LEAST TWO PREDETERMINED BREAK-OFF POINTS. 2) IF BROKEN, LEAVE A PERMANENTLY MAGNETIZED REMNANT AT THE ORIGINAL POINT. 3) MUST BE EXTENDABLE. 4) THE CAP IS INSCRIBED ROCK COUNTY SURVEY MONUMENT - PENALTY FOR DISTURBING MARKER, 5) OR AN EXISTING CUT LIMESTONE. AN IRON PIPE 1 2" x 4'0" (MINIMUM) WITH AT LEAST 4 DURABLE WITNESS MONUMENTS MAY BE USED IN AREAS WHERE GROUND WATER IS WITHIN 1.0' OF THE SURFACE. IF THE CORNER IS OCCUPIED BY AN IMPROVEMENT (MANHOLE, BURIED CABLE, ETC.), ANY DURABLE, DISTINCT MONUMENT MAY BE USED AND REFERENCED WITH AT LEAST 4 DURABLE WITNESS MONUMENTS.

THE CORNER WAS DESTRO	YED BY EXCAVATION	IT IS IMPOSS	IBLE TO SET A
AT THE CORNER. THE COLOR OF THE SWEST/16th	ORNER IS ESTABLISH	HED AT THE MEAN AND THE CENTER	LOCATION OF
Describe any materia corner as restored o corner as previously	r re-established	and the locat	ation of the
NO			
n de la companya de La companya de la co	engan di kacamatan di Kabupatèn Balanda. <u>Per</u> andan di Kabupatèn Balanda di Kabupatèn Balanda di Kabupatèn Balanda di Kabupatèn Balanda di Kabupatèn Bal		National Control of the Control of t
Was the corner restorevidence location or YES	red through acce a found perpetu	ptance of an o	bliterated
			
methods? If so, show	w the method, in	cluding direct	ions and
Was the corner re-est methods? If so, show distances to other pu or used for proportion	w the method, in ublic land surve	cluding direct y corners used	ions and as evidence
methods? If so, show distances to other pu or used for proportion	w the method, in ublic land surve	cluding direct y corners used	ions and as evidence
methods? If so, show distances to other pu or used for proportion	w the method, in ublic land surve	cluding direct y corners used	ions and as evidence
methods? If so, show distances to other put or used for proportion NO NO I, formed formes as, identified by the forme 11 (987 establishment) (9	hereby ce corner code ind clished, re-esta das expressed be as required in	cluding direct y corners used nation of the rtify that t ex were, in a blished, monum elow and in co	he corner portield survey ented, re-months and of survey anual of survey and survey and survey anual of survey and survey anual of survey and survey anual
methods? If so, show distances to other put or used for proportion NO NO I, formed formes as, identified by the forme 11 (987 establishment) (9	hereby ce corner code ind clished, re-esta das expressed be as required in Jnited States De	cluding direct y corners used nation of the rtify that t ex were, in a blished, monum elow and in co the current m partment of In	he corner pofield survey ented, re-monformance wanual of survey terior, Bure
methods? If so, show distances to other pure or used for proportion NO NO I, poned for proportion NO As, identified by the force of certain and rules instructions of the Unit of Land Management.	hereby ce corner code ind clished, re-esta as expressed be as required in United States De	cluding direct y corners used nation of the rtify that t ex were, in a blished, monum elow and in co the current m partment of In	he corner portield survey ented, re-months and of survey anual of survey terior, Bure
methods? If so, show distances to other put or used for proportion NO NO I, formed formes as, identified by the forme 11 (987 establishment) (9	hereby ce corner code ind as expressed by as required in Juited States De	cluding direct y corners used nation of the rtify that t ex were, in a blished, monum elow and in co the current m partment of In URVEYOR FILING Computer Entry	he corner portield survey ented, re-months and of survey anual of survey terior, Bure
methods? If so, show distances to other pure or used for proportion NO NO I, poned for proportion NO As, identified by the covered or restored regulations and rules instructions of the Unit of Land Management. DONALD A.	hereby ce corner code ind clished, re-esta as expressed by as required in United States De COUNTY S Date of Date Rec	cluding direct y corners used nation of the rtify that t ex were, in a blished, monum elow and in co the current m partment of In URVEYOR FILING Computer Entry eived	he corner portield survey ented, re-months and of survey anual of survey terior, Bure
methods? If so, show distances to other properties. NO NO If properties to other properties to the	hereby ce corner code ind clished, re-esta as expressed be as required in Juited States De COUNTY S Date of Date Rec	cluding direct y corners used nation of the rtify that t ex were, in a blished, monum elow and in co the current m partment of In URVEYOR FILING Computer Entry eived	he corner portield survey ented, re-more anual of survey anual of survey terior, Bure